
FIELD TRACE

ANNOTATED FIELD PHOTO + AS-BUILT ISOMETRIC · FT-01

MIMETIC TECHNOLOGY PROTOTYPE · **SAMPLE DATA — NOT FOR CONSTRUCTION**

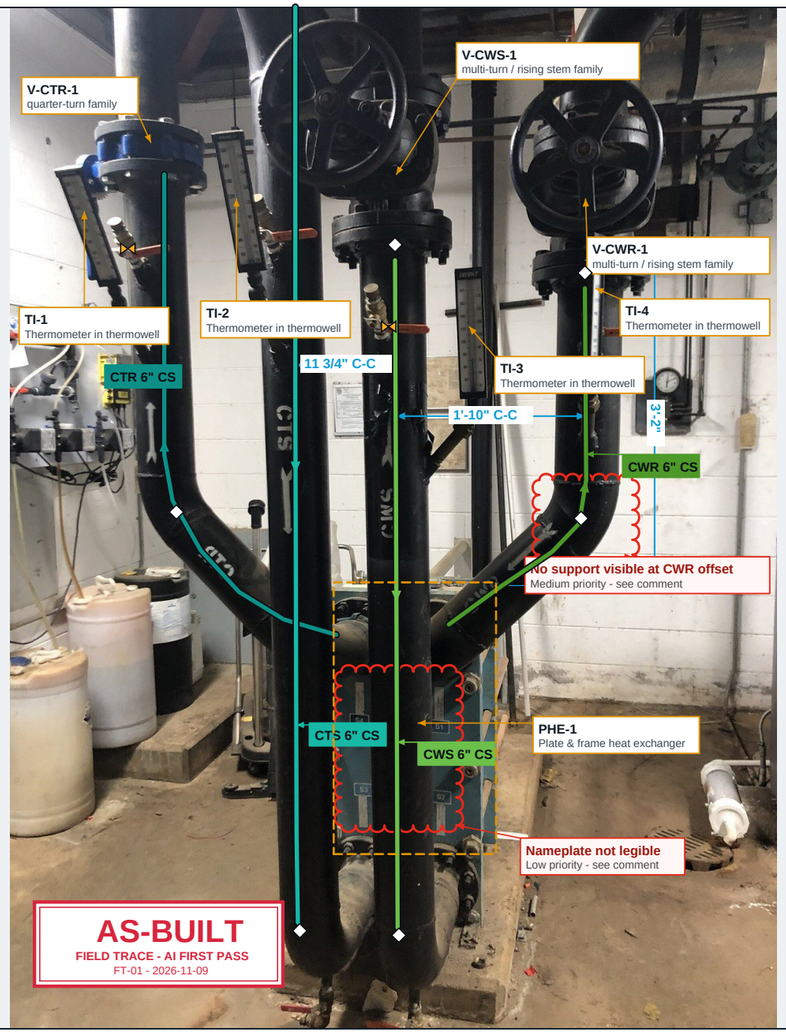


FIELD PHOTO FT-01 · MECH. RM B-104 · NORTH WALL · 2026-11-09 07:42

MARKUPS = EDITABLE PDF ANNOTATIONS · AUTHOR: FIELD TRACE AI

MARKUP SUMMARY — 30 MARKUPS · 2 ISSUES · 0 BELOW 70%

SUBJECT	LABEL	LAYER	STATUS	CONF.
Polyline	CTR 6" CS	Pipe Runs	None	95%
Pipe Tag	CTR 6" CS	Labels	None	80%
Polyline	CTS 6" CS	Pipe Runs	None	93%
Pipe Tag	CTS 6" CS	Labels	None	80%
Polyline	CWS 6" CS	Pipe Runs	None	96%
Pipe Tag	CWS 6" CS	Labels	None	80%
Polyline	CWR 6" CS	Pipe Runs	None	94%
Pipe Tag	CWR 6" CS	Labels	None	80%
Handwheel valve	V-CWS-1	Valves & Instruments	None	92%
Handwheel valve	V-CWR-1	Valves & Instruments	None	91%
Gear-operated valve	V-CTR-1	Valves & Instruments	None	88%
Thermometer in thermowell	TI-1	Valves & Instruments	None	86%
Thermometer in thermowell	TI-2	Valves & Instruments	None	87%
Thermometer in thermowell	TI-3	Valves & Instruments	None	89%
Thermometer in thermowell	TI-4	Valves & Instruments	None	84%

SUBJECT	LABEL	LAYER	STATUS	CONF.
Lever valve (drain / vent)	3/4" Lever valve (drain / vent)	Valves & Instruments	None	79%
Lever valve (drain / vent)	3/4" Lever valve (drain / vent)	Valves & Instruments	None	77%
Flange pair	6" Flange pair	Fittings	None	93%
Flange pair	6" Flange pair	Fittings	None	93%
45° elbow	6" 45° elbow	Fittings	None	90%
45° elbow	6" 45° elbow	Fittings	None	88%
90° LR elbow	6" 90° LR elbow	Fittings	None	71%
90° LR elbow	6" 90° LR elbow	Fittings	None	70%
Plate & frame heat exchanger	PHE-1	Valves & Instruments	None	90%
Dimension	1'-10" C-C	Dimensions	None	82%
Dimension	11 3/4" C-C	Dimensions	None	80%
Dimension	3'-2"	Dimensions	None	74%
Stamp	AS-BUILT — Draft	Labels	None	100%
Cloud+	No support visible at CWR offset	Issues	None	72%
Cloud+	Nameplate not legible	Issues	None	90%

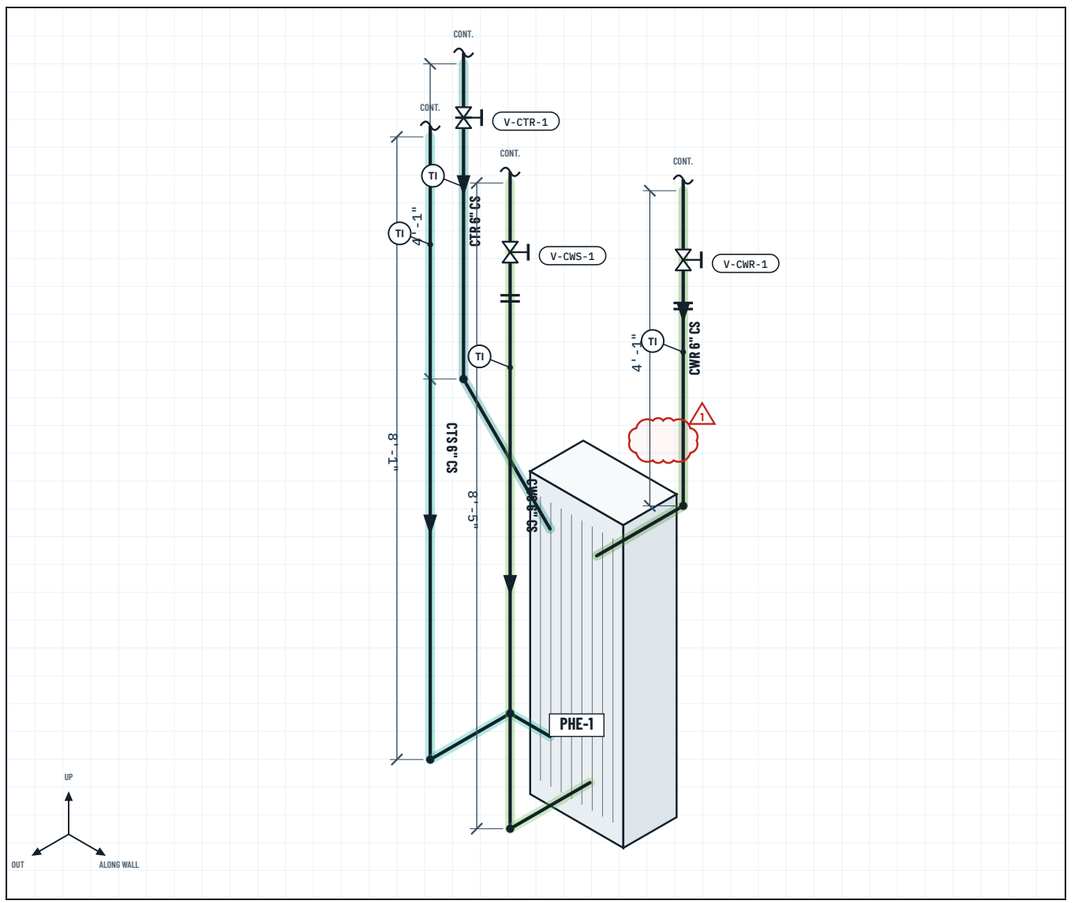

AS-BUILT ISOMETRIC — PLATE HX-1 — TOWER / CONDENSER WATER

N.T.S. · DERIVED FROM PHOTO FT-01 · DIMENSIONS ESTIMATED

GENERAL NOTES

1. ALL PIPING 6" SCH 40 CS, 150# RF FLANGED U.N.O.
2. ELEVATIONS ESTIMATED FROM PHOTO — VERIFY IN FIELD
3. STENCILS READ: CTS · CTR · CWS · CWR

LEGEND

- CTR — Cooling Tower Return
- CTS — Cooling Tower Supply
- CWS — Condenser Water Supply
- CWR — Condenser Water Return
- CS — Carbon steel (sugg.)
- Below 70% — verify

REVISION CLOUDS

△1 No support visible at CWR offset (Medium)
△2 Nameplate not legible (Low)

FIELD TRACE	MIMETIC TECHNOLOGY · MIMETICTECH.AI 80/20 SOFTWARE · PROTOTYPE			
PROJECT Sample Project — Mechanical Rough-In (DEMO-0142)			PREPARED BY MIMETIC TECHNOLOGY	
DRAWING TITLE AS-BUILT — PLATE HX-1 — TOWER / CONDENSER WATER			LOCATION Mech. Rm B-104 · North wall	
SOURCE PHOTO FT-01 · 2026-11-09 07:42	DRAWN FIELD TRACE AI	CHECKED —	SCALE N.T.S.	REV A
STATUS DRAFT — FOR REVIEW IN BLUEBEAM REVU 21.11			SHEET FT-01	

SAMPLE DATA · PUBLIC LICENSED PHOTO · NOT A CLIENT JOB PHOTO · NOT FOR CONSTRUCTION