
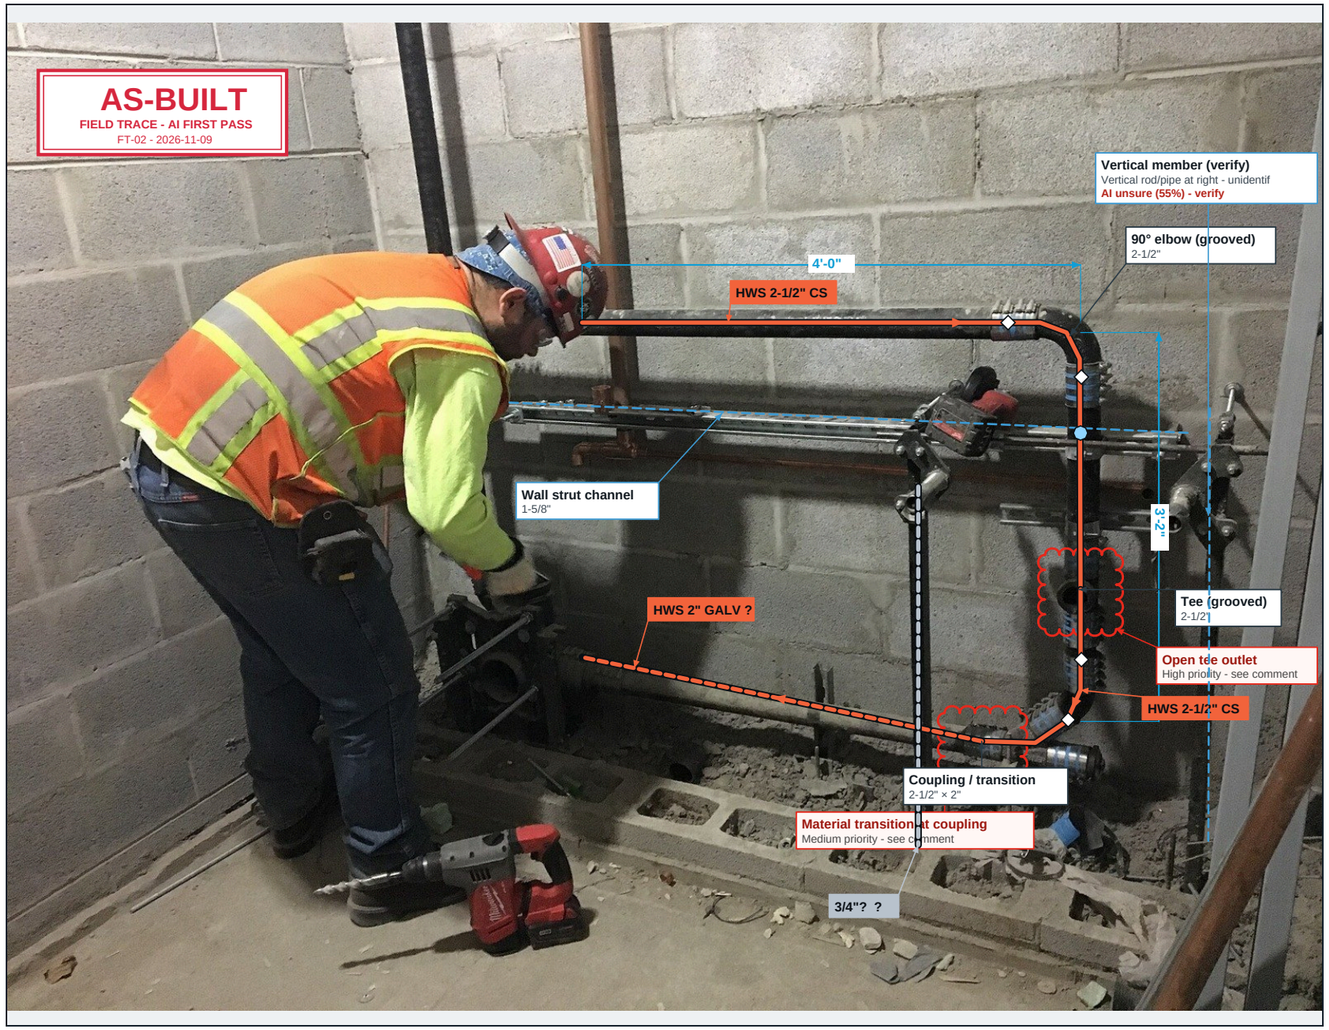


FIELD PHOTO FT-02 · LEVEL B1 · CORRIDOR C, COLUMN LINE 4 · 2026-11-09 09:15

MARKUPS = EDITABLE PDF ANNOTATIONS · AUTHOR: FIELD TRACE AI

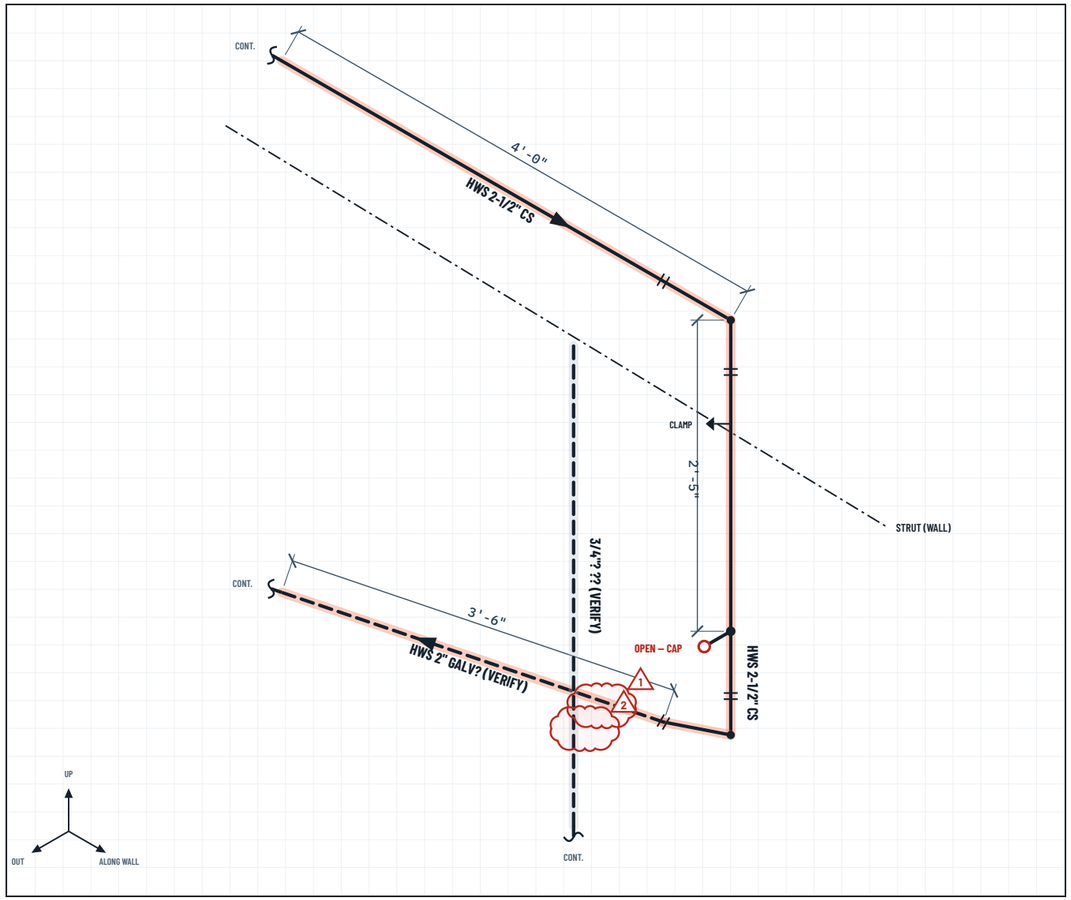

AS-BUILT ISOMETRIC — HWS OFFSET AT CMU WALL — ROUGH-IN

N.T.S. · DERIVED FROM PHOTO FT-02 · DIMENSIONS ESTIMATED

MARKUP SUMMARY — 23 MARKUPS · 2 ISSUES · 6 BELOW 70%

SUBJECT	LABEL	LAYER	STATUS	CONF.
Polyline	HWS 2-1/2" CS	Pipe Runs	None	91%
Pipe Tag	HWS 2-1/2" CS	Labels	None	80%
Polyline	HWS 2-1/2" CS	Pipe Runs	None	86%
Pipe Tag	HWS 2-1/2" CS	Labels	None	80%
Polyline	HWS 2" GALV?	Pipe Runs	None	68%
Pipe Tag	HWS 2" GALV?	Labels	None	60%
Polyline	3/4"? ??	Pipe Runs	None	58%
Pipe Tag	3/4"? ??	Labels	None	50%
Rigid coupling	2-1/2" Rigid coupling	Fittings	None	93%
90° elbow (grooved)	2-1/2" 90° elbow (grooved)	Fittings	None	94%
Rigid coupling	2-1/2" Rigid coupling	Fittings	None	90%
Tee (grooved)	2-1/2" Tee (grooved)	Fittings	None	87%

SUBJECT	LABEL	LAYER	STATUS	CONF.
Rigid coupling	2-1/2" Rigid coupling	Fittings	None	88%
90° elbow (grooved)	2-1/2" 90° elbow (grooved)	Fittings	None	83%
Coupling / transition	2-1/2" × 2" Coupling / transition	Fittings	None	70%
Wall strut channel	1-5/8" Wall strut channel	Hangers & Supports	None	92%
Pipe clamp at strut	2-1/2" Pipe clamp at strut	Hangers & Supports	None	80%
Vertical member (verify)	Vertical member (verify)	Hangers & Supports	None	55%
Dimension	4'-0"	Dimensions	None	81%
Dimension	3'-2"	Dimensions	None	78%
Stamp	AS-BUILT — Draft	Labels	None	100%
Cloud+	Open tee outlet	Issues	None	85%
Cloud+	Material transition at coupling	Issues	None	68%

GENERAL NOTES

1. 2-1/2" GROOVED STEEL, RIGID COUPLINGS U.N.O.
2. DIMENSIONS FROM CMU COURSING — ±2"
3. DASHED = BELOW CONFIDENCE THRESHOLD, VERIFY

LEGEND

- HWS — Heating Hot Water Supply
- CS — Carbon steel (sugg.)
- GALV — Galvanized steel (sugg.)
- ? — Not determinable (sugg.)
- Below 70% — verify

REVISION CLOUDS

△1 Open tee outlet (High)
△2 Material transition at coupling (Medium)

FIELD TRACE

MIMETIC TECHNOLOGY · MIMETICTECH.AI
80/20 SOFTWARE · PROTOTYPE

PROJECT: Sample Project — Mechanical Rough-In (DEMO-0142)			PREPARED BY: MIMETIC TECHNOLOGY	
DRAWING TITLE: AS-BUILT — HWS OFFSET AT CMU WALL — ROUGH-IN			LOCATION: Level B1 · Corridor C, column line 4	
SOURCE PHOTO: FT-02 · 2026-11-09 09:15	DRAWN: FIELD TRACE AI	CHECKED: —	SCALE: N.T.S.	REV: A
STATUS: DRAFT — FOR REVIEW IN BLUEBEAM REVU 21.11			SHEET: FT-02	

SAMPLE DATA · PUBLIC LICENSED PHOTO · NOT A CLIENT JOB PHOTO · NOT FOR CONSTRUCTION