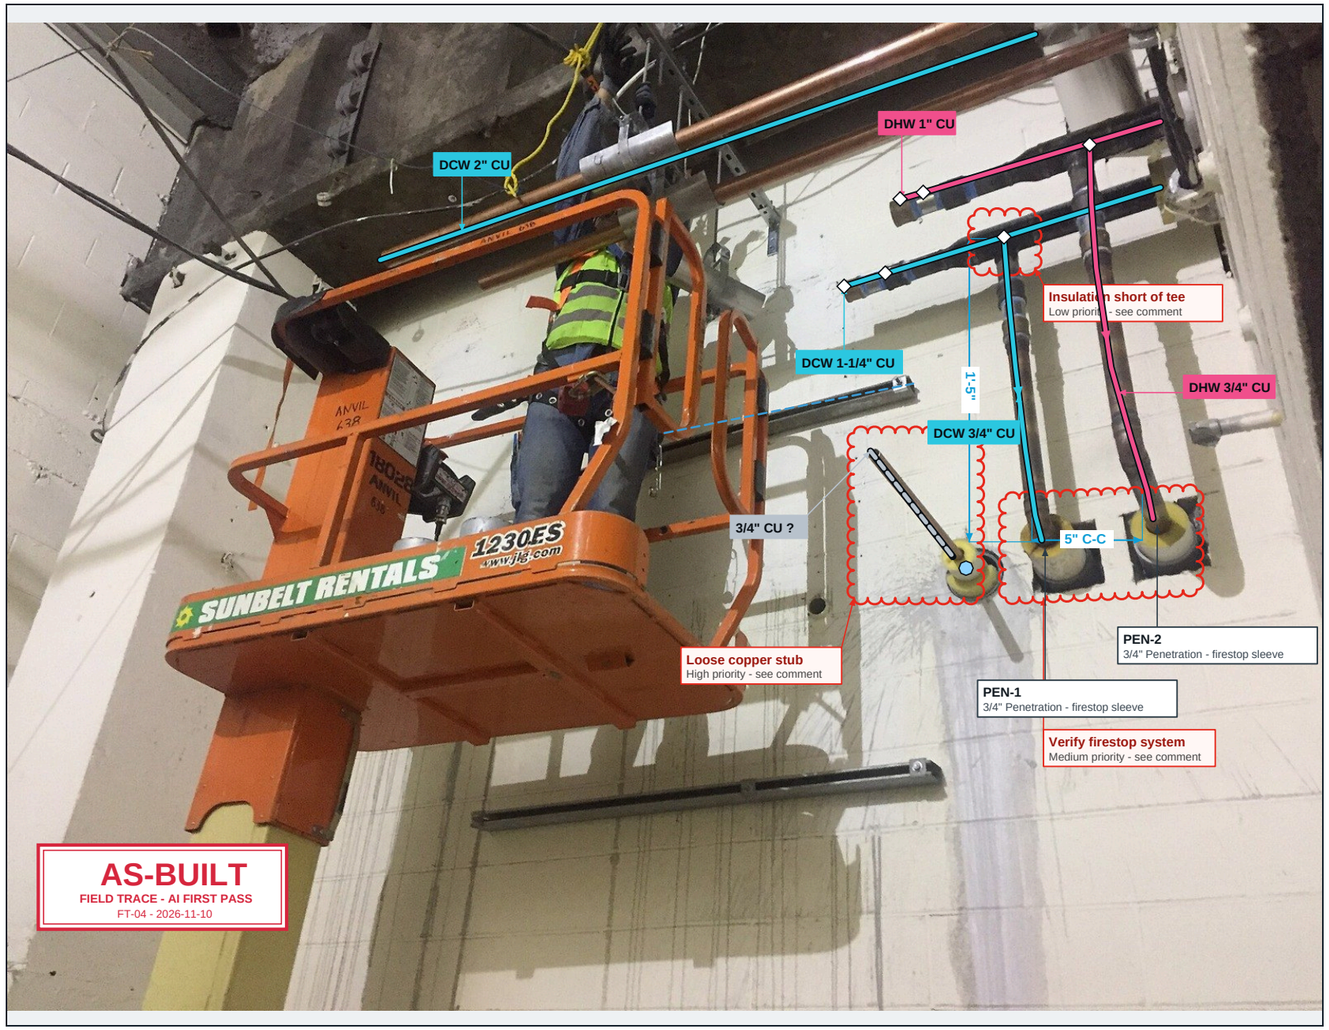



FIELD PHOTO FT-04 · LEVEL 1 · BACK-OF-HOUSE WALL W-12 · 2026-11-10 15:31

MARKUPS = EDITABLE PDF ANNOTATIONS · AUTHOR: FIELD TRACE AI

MARKUP SUMMARY — 28 MARKUPS · 3 ISSUES · 4 BELOW 70%

SUBJECT	LABEL	LAYER	STATUS	CONF.
Polyline	DCW 1-1/4" CU	Pipe Runs	None	85%
Pipe Tag	DCW 1-1/4" CU	Labels	None	78%
Polyline	DHW 1" CU	Pipe Runs	None	83%
Pipe Tag	DHW 1" CU	Labels	None	78%
Polyline	DCW 3/4" CU	Pipe Runs	None	88%
Pipe Tag	DCW 3/4" CU	Labels	None	88%
Polyline	DHW 3/4" CU	Pipe Runs	None	76%
Pipe Tag	DHW 3/4" CU	Labels	None	76%
Polyline	DCW 2" CU	Pipe Runs	None	72%
Pipe Tag	DCW 2" CU	Labels	None	72%
Polyline	3/4" CU	Pipe Runs	None	60%
Pipe Tag	3/4" CU	Labels	None	60%
Tee	1-1/4" × 3/4" Tee	Fittings	None	84%
Tee (assumed)	1" × 3/4" Tee (assumed)	Fittings	None	66%

SUBJECT	LABEL	LAYER	STATUS	CONF.
Press coupling	1" Press coupling	Fittings	None	82%
Press coupling	1-1/4" Press coupling	Fittings	None	82%
Cap (stub-out)	1" Cap (stub-out)	Fittings	None	75%
Cap (stub-out)	1-1/4" Cap (stub-out)	Fittings	None	75%
Penetration — firestop sleeve	PEN-1	Hangers & Supports	None	90%
Penetration — firestop sleeve	PEN-2	Hangers & Supports	None	90%
Penetration — firestop sleeve	PEN-3	Hangers & Supports	None	86%
Wall strut channel	1-5/8" Wall strut channel	Hangers & Supports	None	85%
Dimension	5" C-C	Dimensions	None	72%
Dimension	1'-5"	Dimensions	None	70%
Stamp	AS-BUILT — Draft	Labels	None	100%
Cloud+	Verify firestop system	Issues	None	80%
Cloud+	Loose copper stub	Issues	None	74%
Cloud+	Insulation short of tee	Issues	None	69%

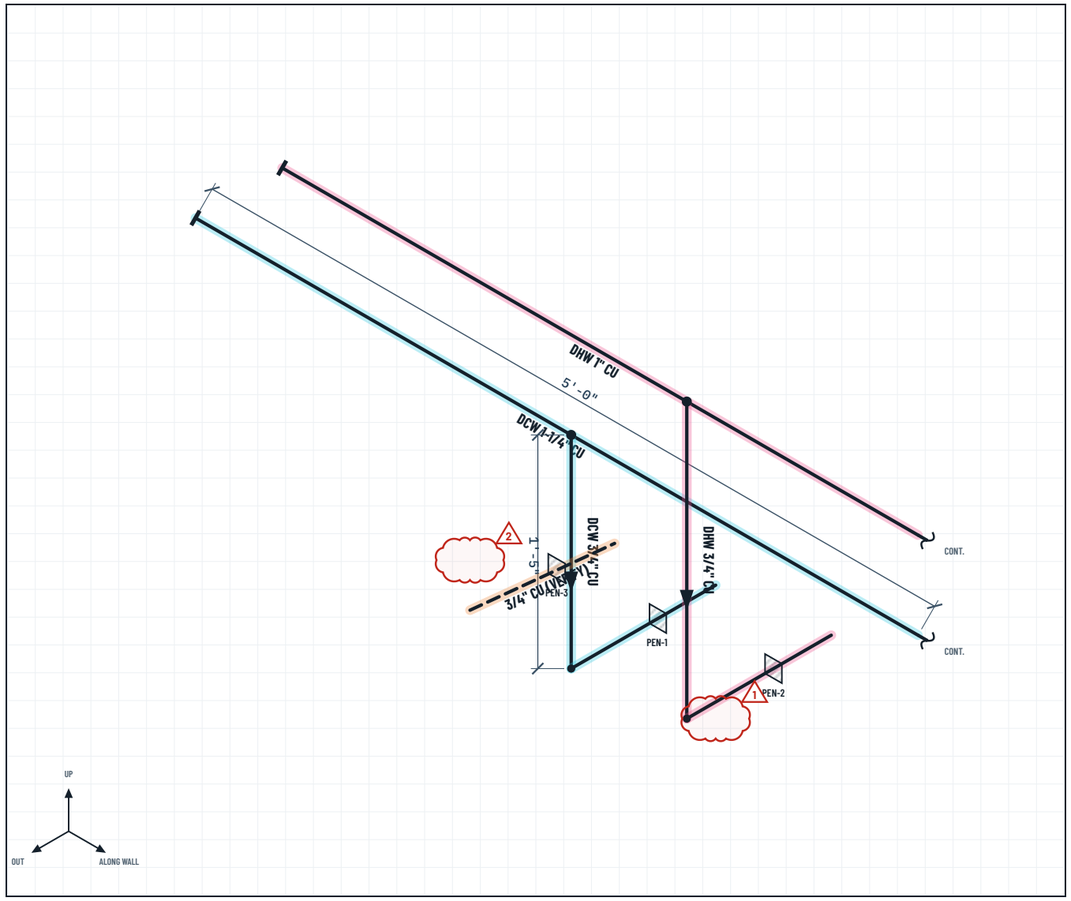

AS-BUILT ISOMETRIC — DOMESTIC WATER DROPS AT WALL PENETRATIONS

N.T.S. · DERIVED FROM PHOTO FT-04 · DIMENSIONS ESTIMATED

GENERAL NOTES

1. TYPE L COPPER, PRESS FITTINGS U.N.O.
2. PENETRATIONS: SLEEVED, FIRESTOPPED — SYSTEM NO. TBD
3. R5 OVERHEAD 2" DCW NOT SHOWN (OCCLUDED)

LEGEND

- DCW — Domestic Cold Water
- DHW — Domestic Hot Water
- CU — Copper (sugg.)
- Below 70% — verify

REVISION CLOUDS

△1 Verify firestop system (Medium)
△2 Loose copper stub (High)
△3 Insulation short of tee (Low)

FIELD TRACE

MIMETIC TECHNOLOGY · MIMETICTECH.AI
80/20 SOFTWARE · PROTOTYPE

PROJECT: Sample Project — Mechanical Rough-In (DEMO-0142)			PREPARED BY: MIMETIC TECHNOLOGY	
DRAWING TITLE: AS-BUILT — DOMESTIC WATER DROPS AT WALL PENETRATIONS			LOCATION: Level 1 · Back-of-house wall W-12	
SOURCE PHOTO: FT-04 · 2026-11-10 15:31	DRAWN: FIELD TRACE AI	CHECKED: —	SCALE: N.T.S.	REV: A
STATUS: DRAFT — FOR REVIEW IN BLUEBEAM REVU 21.11			SHEET: FT-04	

SAMPLE DATA · PUBLIC LICENSED PHOTO · NOT A CLIENT JOB PHOTO · NOT FOR CONSTRUCTION