
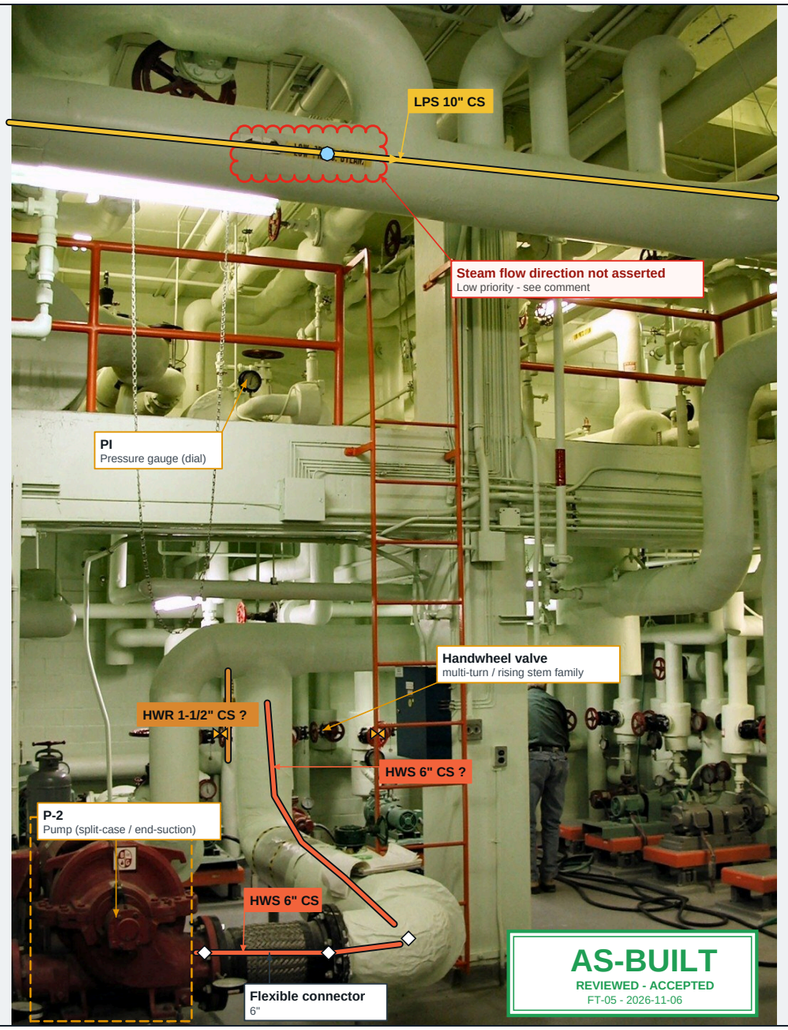


FIELD PHOTO FT-05 · CENTRAL PLANT · PUMP ROOM · 2026-11-06 10:20

MARKUPS = EDITABLE PDF ANNOTATIONS · AUTHOR: FIELD TRACE AI

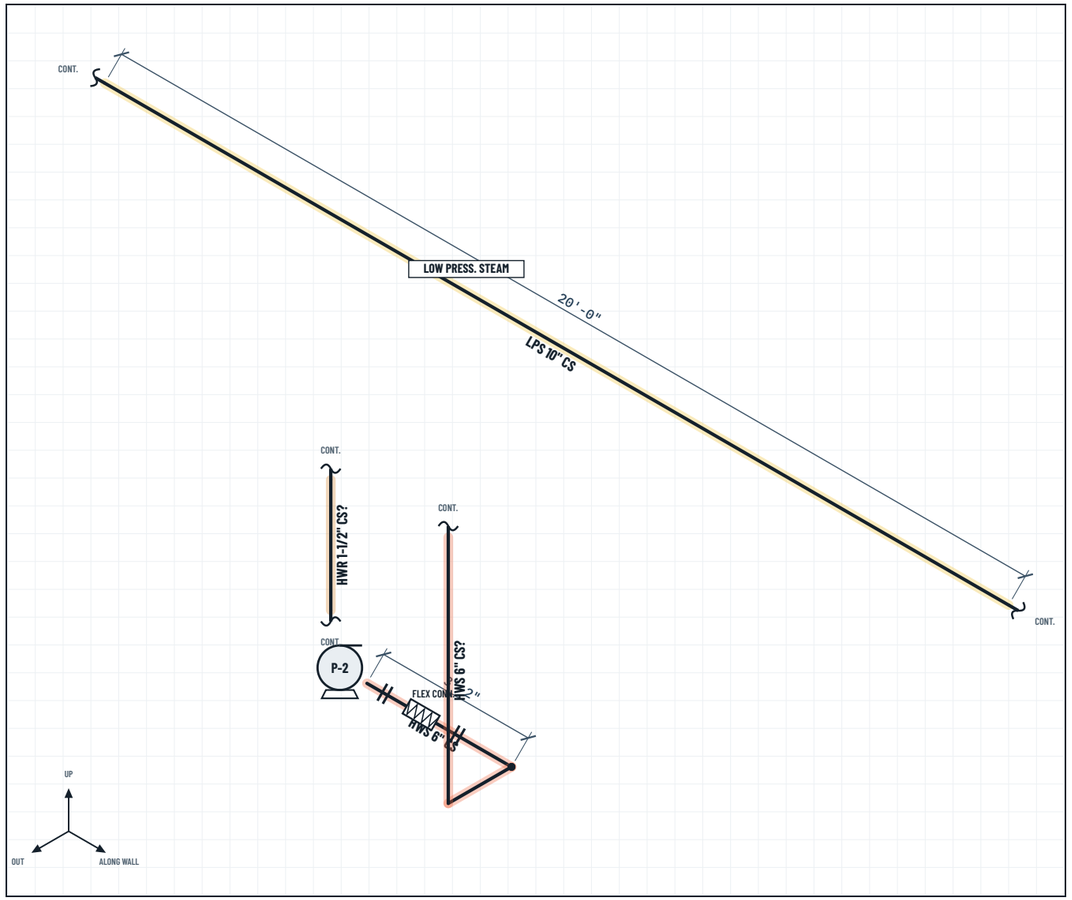

AS-BUILT ISOMETRIC — LP STEAM HEADER & PUMP SET

N.T.S. · DERIVED FROM PHOTO FT-05 · DIMENSIONS ESTIMATED

MARKUP SUMMARY — 20 MARKUPS · 1 ISSUES · 2 BELOW 70%

SUBJECT	LABEL	LAYER	STATUS	CONF.
Polyline	LPS 10" CS	Pipe Runs	Accepted	93%
Pipe Tag	LPS 10" CS	Labels	Accepted	70%
Polyline	HWS 6" CS	Pipe Runs	Accepted	87%
Pipe Tag	HWS 6" CS	Labels	Accepted	80%
Polyline	HWS 6" CS?	Pipe Runs	Accepted	74%
Pipe Tag	HWS 6" CS?	Labels	Accepted	55%
Polyline	HWR 1-1/2" CS?	Pipe Runs	Accepted	70%
Pipe Tag	HWR 1-1/2" CS?	Labels	Accepted	55%
Pump (split-case / end-suction)	P-2	Valves & Instruments	Accepted	88%
Flexible connector	6" Flexible connector	Fittings	Accepted	92%
Flange pair	6" Flange pair	Fittings	Accepted	90%
Flange pair	6" Flange pair	Fittings	Accepted	90%
90° elbow (insulated)	6" 90° elbow (insulated)	Fittings	Accepted	82%
Handwheel valve	2" Handwheel valve	Valves & Instruments	Accepted	78%
Handwheel valve	2" Handwheel valve	Valves & Instruments	Accepted	78%
Handwheel valve	2" Handwheel valve	Valves & Instruments	Accepted	76%
Pressure gauge (dial)	PI	Valves & Instruments	Accepted	83%
Pipe marker (read)	LOW PRESS. STEAM	Labels	Accepted	95%
Stamp	AS-BUILT — Reviewed	Labels	Accepted	100%
Cloud+	Steam flow direction not asserted	Issues	Accepted	90%

GENERAL NOTES

1. REVIEWED SET — ALL MARKUPS ACCEPTED
2. CONTINUATIONS SHOWN WITH BREAK SYMBOL
3. HEADER LENGTH IN FRAME ≈ 20'-0" (ESTIMATED)

LEGEND

- LPS — Low Pressure Steam
- HWS — Heating Hot Water Supply
- HWR — Heating Hot Water Return
- CS — Carbon steel (sugg.)
- Below 70% — verify

REVISION CLOUDS

△1 Steam flow direction not asserted (Low)

FIELD TRACE

MIMETIC TECHNOLOGY · MIMETICTECH.AI
80/20 SOFTWARE · PROTOTYPE

PROJECT: Sample Project — Mechanical Rough-In (DEMO-0142)			PREPARED BY: MIMETIC TECHNOLOGY	
DRAWING TITLE: AS-BUILT — LP STEAM HEADER & PUMP SET			LOCATION: Central plant · Pump room	
SOURCE PHOTO: FT-05 · 2026-11-06 10:20	DRAWN: FIELD TRACE AI	CHECKED: R. (REVIEWER)	SCALE: N.T.S.	REV: 0
STATUS: REVIEWED — ISSUED AS-BUILT			SHEET: FT-05	

SAMPLE DATA · PUBLIC LICENSED PHOTO · NOT A CLIENT JOB PHOTO · NOT FOR CONSTRUCTION