
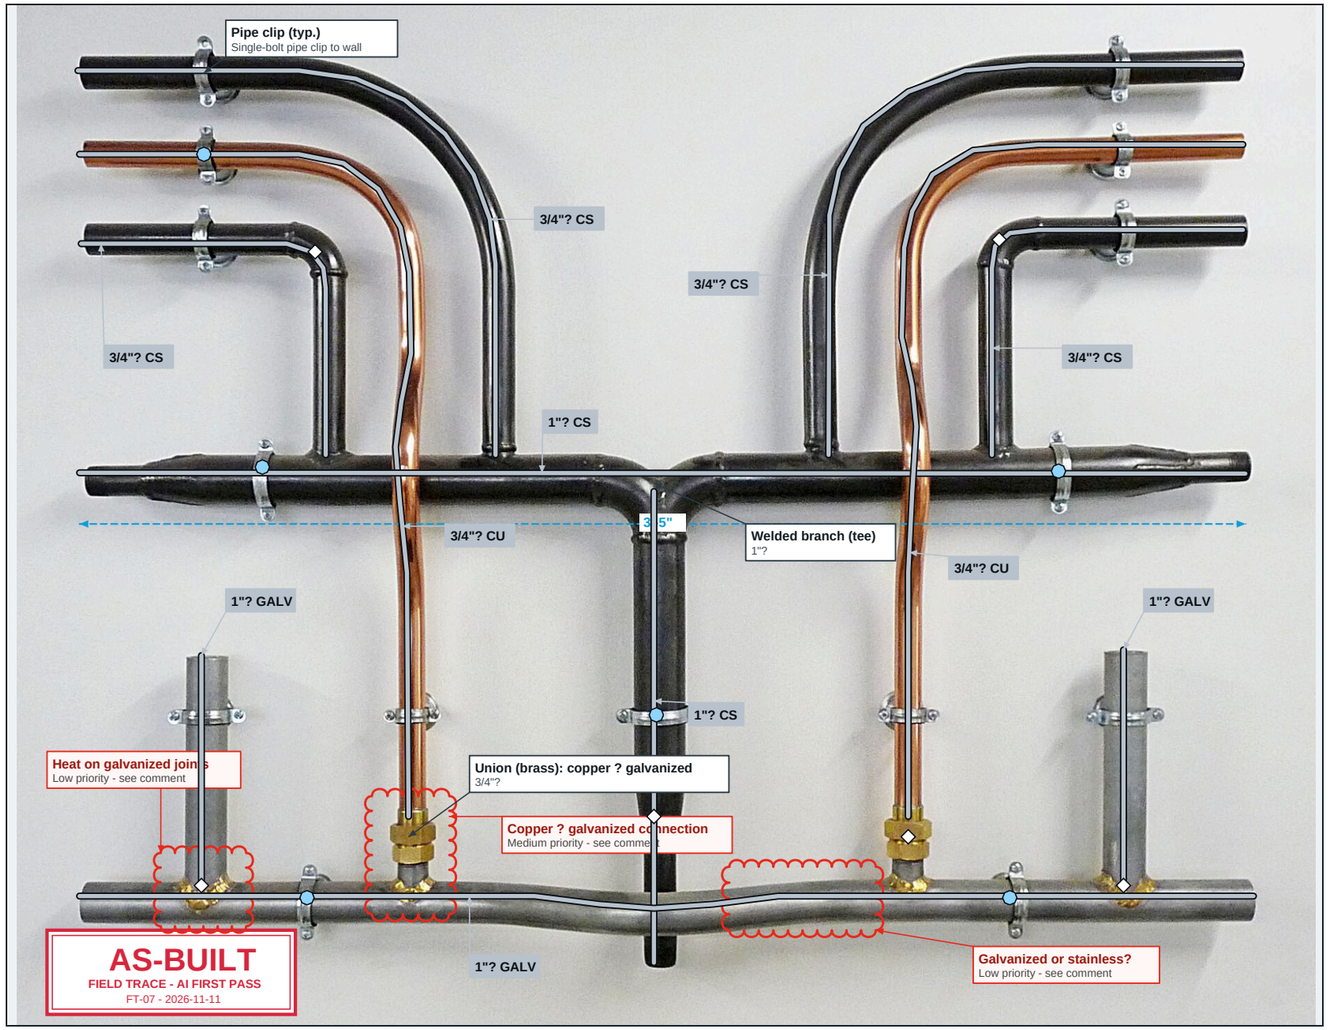


FIELD PHOTO FT-07 · PREFAB SHOP · MOCK-UP WALL · 2026-11-11 08:10

MARKUPS = EDITABLE PDF ANNOTATIONS · AUTHOR: FIELD TRACE AI

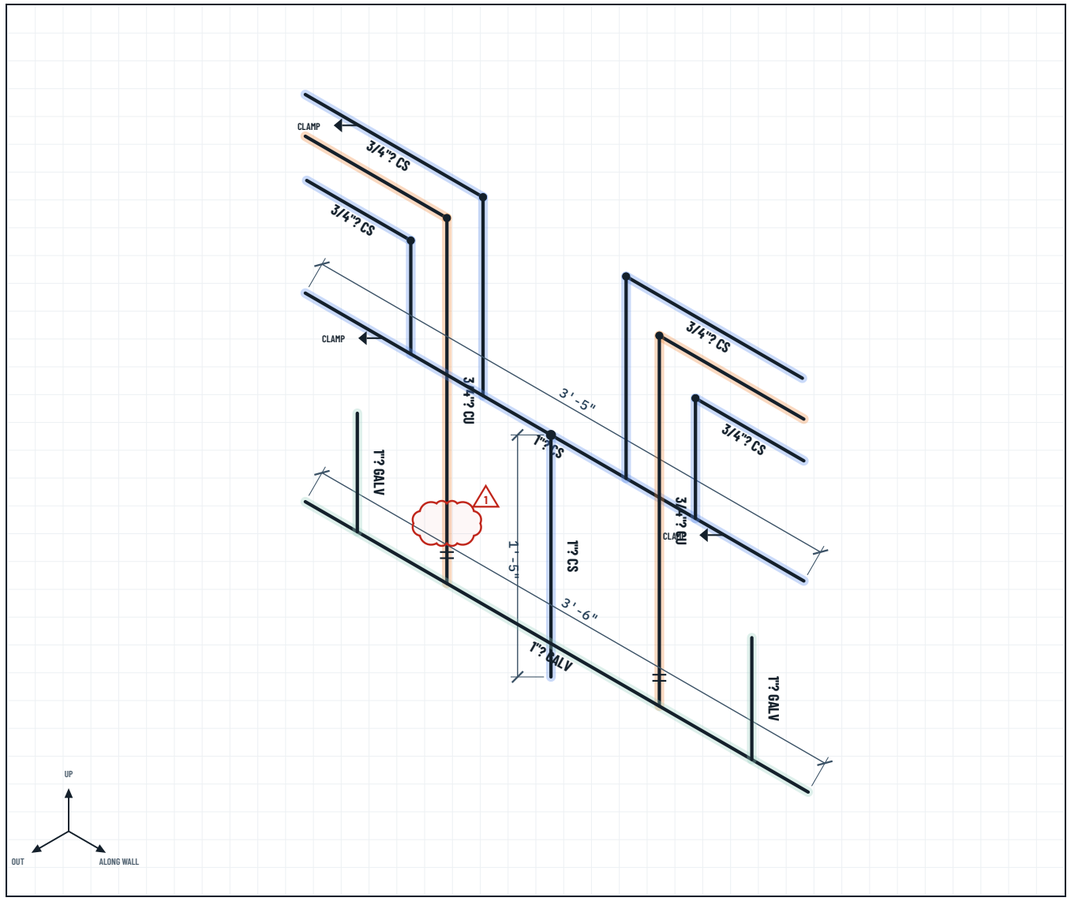

AS-BUILT ISOMETRIC — MIXED MATERIALS — BLACK STEEL, COPPER, GALVANIZED

N.T.S. · DERIVED FROM PHOTO FT-07 · DIMENSIONS ESTIMATED

MARKUP SUMMARY — 42 MARKUPS · 3 ISSUES · 2 BELOW 70%

SUBJECT	LABEL	LAYER	STATUS	CONF.
Polyline	3/4"? CS	Pipe Runs	None	90%
Pipe Tag	3/4"? CS	Labels	None	90%
Polyline	3/4"? CU	Pipe Runs	None	92%
Pipe Tag	3/4"? CU	Labels	None	92%
Polyline	3/4"? CS	Pipe Runs	None	90%
Pipe Tag	3/4"? CS	Labels	None	88%
Polyline	1"? CS	Pipe Runs	None	93%
Pipe Tag	1"? CS	Labels	None	90%
Polyline	3/4"? CS	Pipe Runs	None	90%
Pipe Tag	3/4"? CS	Labels	None	90%
Polyline	3/4"? CU	Pipe Runs	None	91%
Pipe Tag	3/4"? CU	Labels	None	91%
Polyline	3/4"? CS	Pipe Runs	None	90%
Pipe Tag	3/4"? CS	Labels	None	88%
Polyline	1"? CS	Pipe Runs	None	88%
Pipe Tag	1"? CS	Labels	None	88%
Polyline	1"? GALV	Pipe Runs	None	86%
Pipe Tag	1"? GALV	Labels	None	74%
Polyline	1"? GALV	Pipe Runs	None	88%
Pipe Tag	1"? GALV	Labels	None	72%
Polyline	1"? GALV	Pipe Runs	None	88%

SUBJECT	LABEL	LAYER	STATUS	CONF.
Pipe Tag	1"? GALV	Labels	None	72%
Welded branch (tee)	1"? Welded branch (tee)	Fittings	None	88%
90° elbow (welded)	3/4"? 90° elbow (welded)	Fittings	None	86%
90° elbow (welded)	3/4"? 90° elbow (welded)	Fittings	None	86%
Concentric reducer (swaged)	Concentric reducer (swaged)	Fittings	None	80%
Union (brass): copper → galvanized	3/4"? Union (brass): copper → galvanized	Fittings	None	85%
Union (brass): copper → galvanized	3/4"? Union (brass): copper → galvanized	Fittings	None	85%
Brazed branch joint	Brazed branch joint	Fittings	None	78%
Brazed branch joint	Brazed branch joint	Fittings	None	78%
Pipe clip (typ.)	Pipe clip (typ.)	Hangers & Supports	None	90%
Pipe clip	Pipe clip	Hangers & Supports	None	88%
Pipe clip	Pipe clip	Hangers & Supports	None	88%
Pipe clip	Pipe clip	Hangers & Supports	None	88%
Pipe clip	Pipe clip	Hangers & Supports	None	88%
Pipe clip	Pipe clip	Hangers & Supports	None	86%
Pipe clip	Pipe clip	Hangers & Supports	None	86%
Dimension	3'-5"	Dimensions	None	66%
Stamp	AS-BUILT — Draft	Labels	None	100%
Cloud+	Copper ↔ galvanized connection	Issues	None	82%
Cloud+	Heat on galvanized joints	Issues	None	70%
Cloud+	Galvanized or stainless?	Issues	None	66%

GENERAL NOTES

1. SCALE FROM COPPER OD (22 MM ASSUMED): LENGTHS APPROXIMATE
2. BENDS SHOWN AS CORNERS. BENT PIPE, NO FITTING
3. MATERIALS SUGGESTED: CS BLACK · CU · GALV. VERIFY

LEGEND

- CS — Carbon steel (sugg.)
- CU — Copper (sugg.)
- GALV — Galvanized steel (sugg.)
- Below 70% — verify

REVISION CLOUDS

△1 Copper ↔ galvanized connection (Medium)
△2 Heat on galvanized joints (Low)
△3 Galvanized or stainless? (Low)

FIELD TRACE

MIMETIC TECHNOLOGY · MIMETICTECH.AI
80/20 SOFTWARE · PROTOTYPE

PROJECT: Sample Project — Mechanical Rough-In (DEMO-0142)			PREPARED BY: MIMETIC TECHNOLOGY
DRAWING TITLE: AS-BUILT — MIXED MATERIALS — BLACK STEEL, COPPER, GALVANIZED			LOCATION: Prefab shop · mock-up wall
SOURCE PHOTO: FT-07 · 2026-11-11 08:10	DRAWN: FIELD TRACE AI	CHECKED: —	SCALE: N.T.S. / REV: A
STATUS: DRAFT — FOR REVIEW IN BLUEBEAM REVU 21.11			SHEET: FT-07

SAMPLE DATA · PUBLIC LICENSED PHOTO · NOT A CLIENT JOB PHOTO · NOT FOR CONSTRUCTION