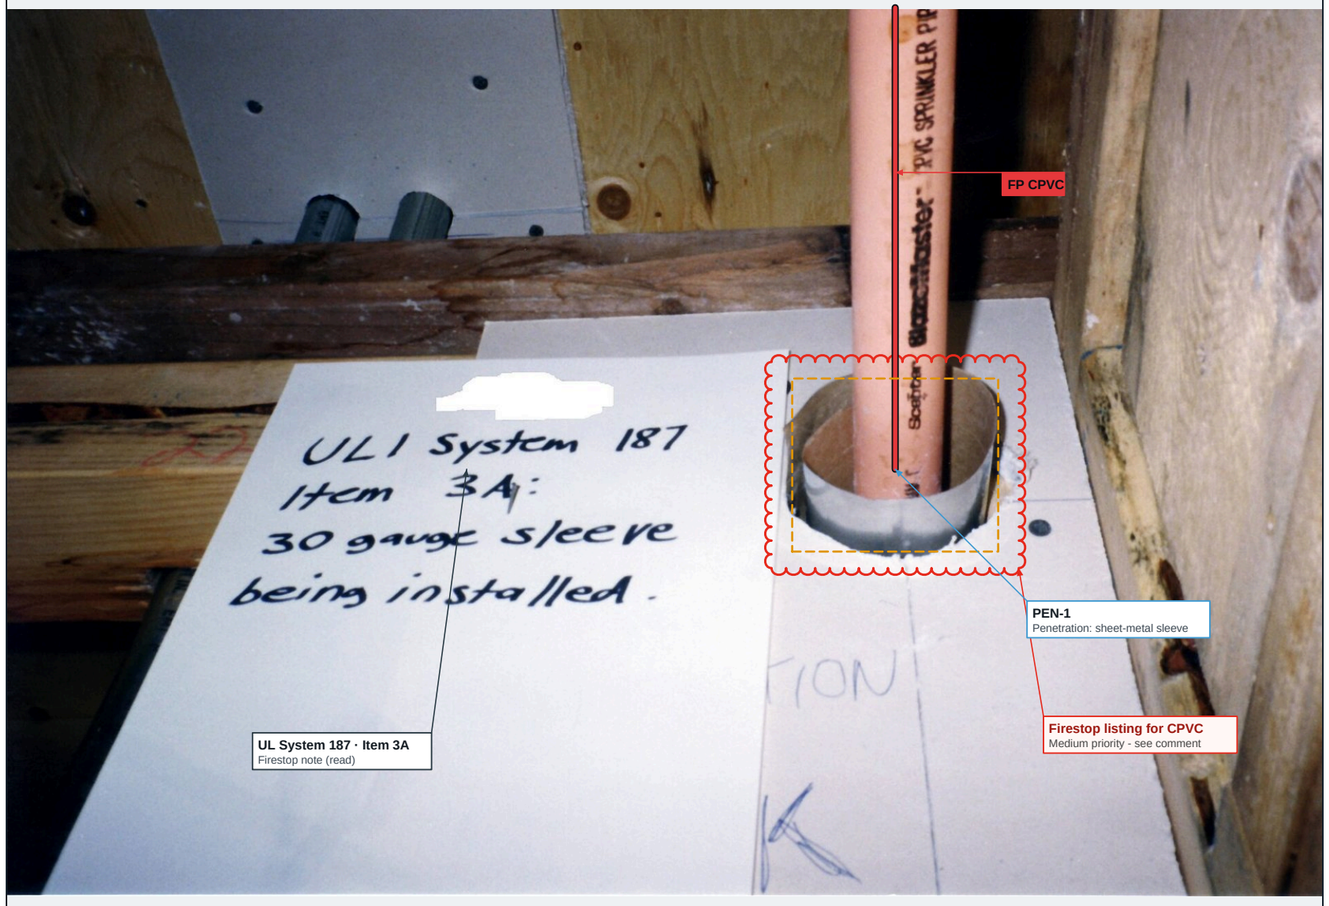


FIELD PHOTO FT-10 · WOOD-FRAME FLOOR · PENETRATION · 2026-11-11 15:40

MARKUPS = EDITABLE PDF ANNOTATIONS · AUTHOR: FIELD TRACE AI

MARKUP SUMMARY — 5 MARKUPS · 1 ISSUES · 0 BELOW 70%

SUBJECT	LABEL	LAYER	STATUS	CONF.
Polyline	FP CPVC	Pipe Runs	None	90%
Pipe Tag	FP CPVC	Labels	None	90%
Penetration: sheet-metal sleeve	PEN-1	Hangers & Supports	None	88%

SUBJECT	LABEL	LAYER	STATUS	CONF.
Firestop note (read)	UL System 187 · Item 3A	Labels	None	80%
Cloud+	Firestop listing for CPVC	Issues	None	80%

AS-BUILT ISOMETRIC: HELD

Single vertical run, no scale. Not drafted.

Run	Material (sugg.)	Size	OD	Schedule (sugg.)
R1	CPVC	?	IPS convention · needs a scale	SDR 13.5

Wall thickness is not visible from a photo. Rating and corrosion allowance need verification.

RUN SCHEDULE — CPVC SPRINKLER PIPE AT A FIRESTOP SLEEVE

NO ISO DRAFTED · MATERIALS AND SCHEDULES SUGGESTED

GENERAL NOTES

1. Single vertical run, no scale. Not drafted.
2. SCHEDULES ARE SUGGESTED. WALL IS NOT VISIBLE IN A PHOTO. VERIFY

LEGEND

- FP — Fire Protection
- COMP — Composite & plastic (sugg.)
- Below 70% — verify

REVISION CLOUDS

△1 Firestop listing for CPVC (Medium)

FIELD TRACE

MIMETIC TECHNOLOGY · MIMETICTECH.AI
80/20 SOFTWARE · PROTOTYPE

PROJECT: Sample Project — Mechanical Rough-In (DEMO-0142)			PREPARED BY: MIMETIC TECHNOLOGY	
DRAWING TITLE: AS-BUILT — CPVC SPRINKLER PIPE AT A FIRESTOP SLEEVE			LOCATION: Wood-frame floor · penetration	
SOURCE PHOTO: FT-10 · 2026-11-11 15:40	DRAWN: FIELD TRACE AI	CHECKED: —	SCALE: N.T.S.	REV: A
STATUS: DRAFT — FOR REVIEW IN BLUEBEAM REVU 21.11			SHEET: FT-10	

SAMPLE DATA · PUBLIC LICENSED PHOTO · NOT A CLIENT JOB PHOTO · NOT FOR CONSTRUCTION