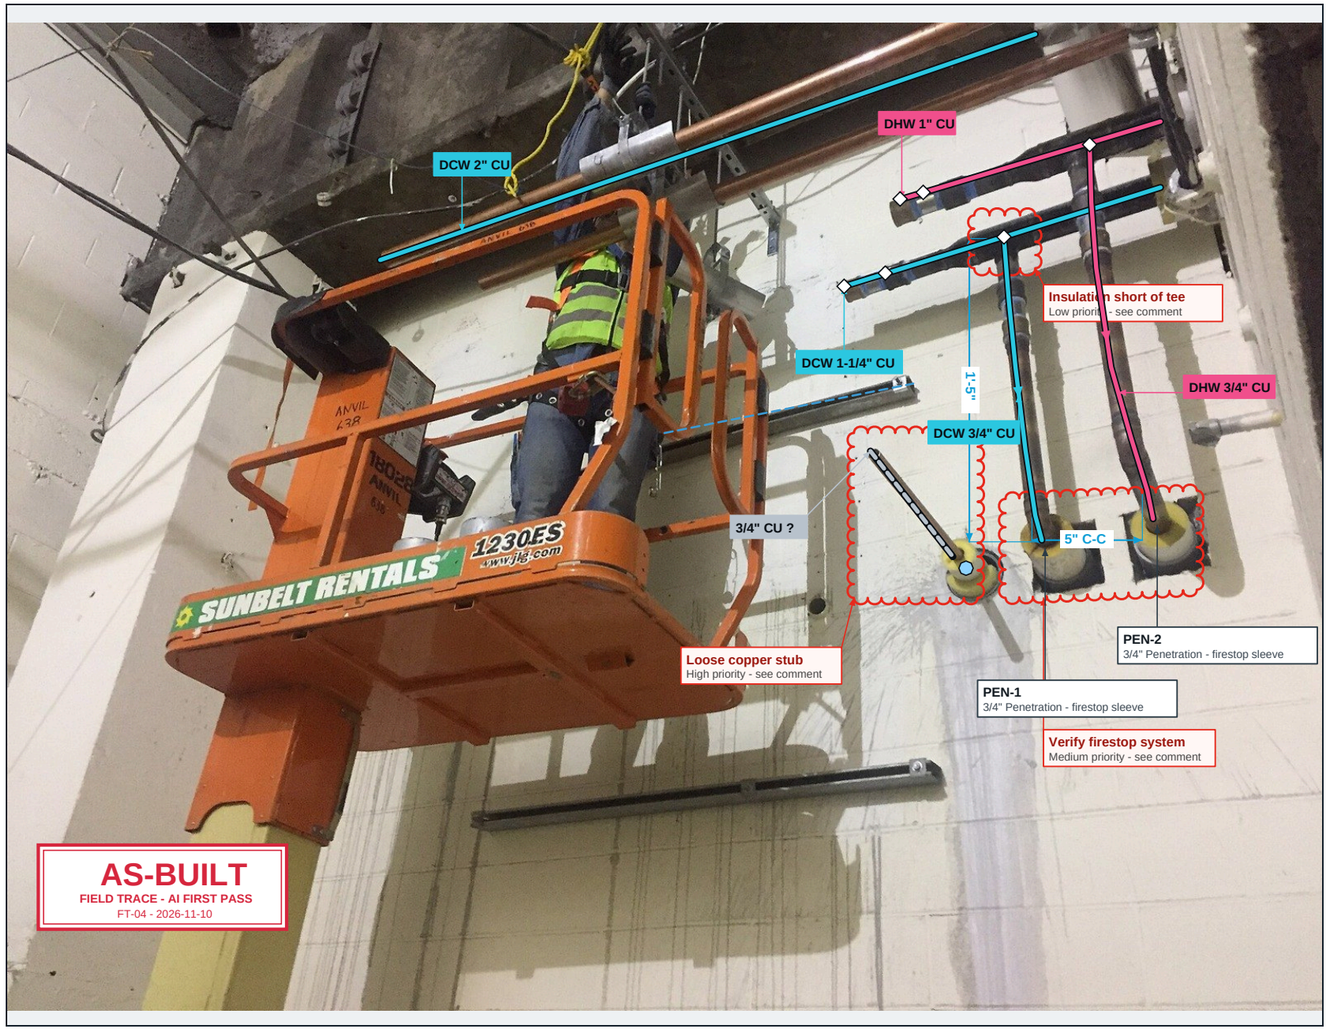


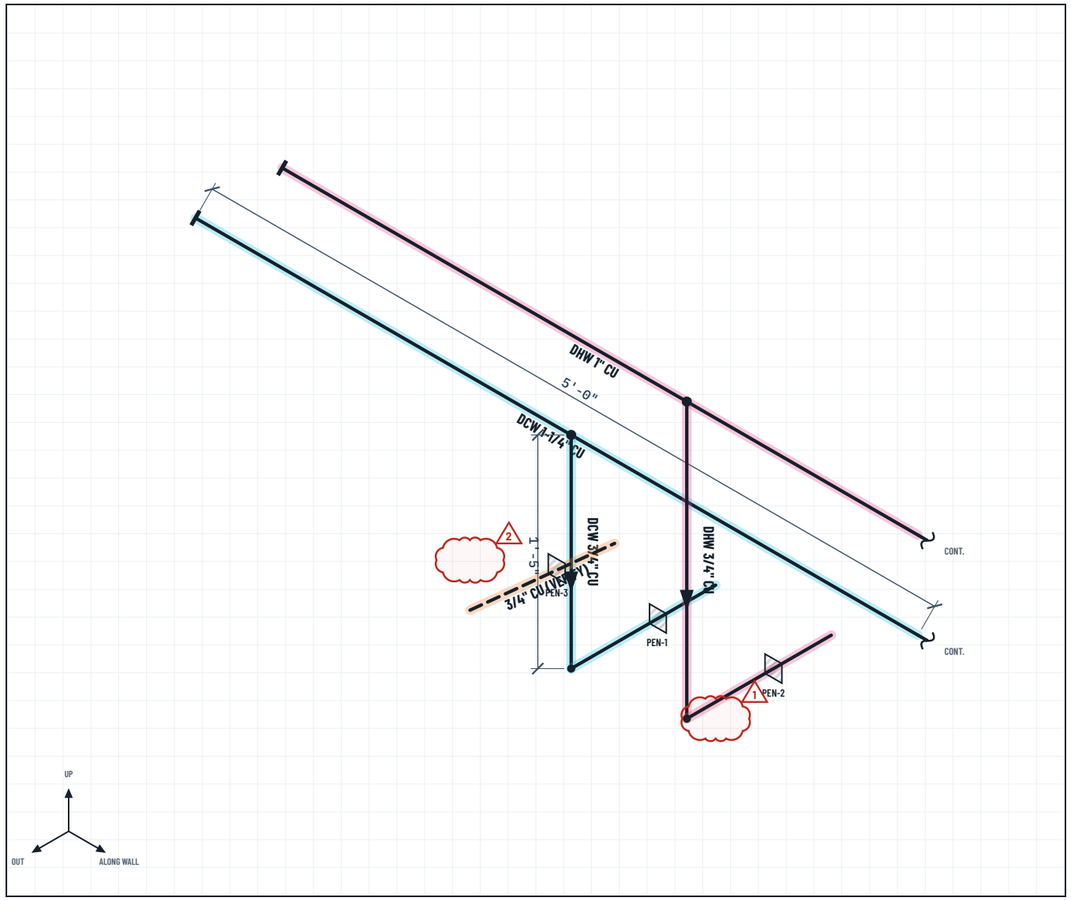

FIELD PHOTO FT-04 · LEVEL 1 · BACK-OF-HOUSE WALL W-12 · 2026-11-10 15:31

MARKUPS = EDITABLE PDF ANNOTATIONS · AUTHOR: FIELD TRACE AI

## MARKUP SUMMARY — 28 MARKUPS · 3 ISSUES · 4 BELOW 70%

| SUBJECT | LABEL | LAYER | STATUS | CONF. |
|---|---|---|---|---|
| Polyline | DCW 1-1/4" CU | Pipe Runs | None | 85% |
| Pipe Tag | DCW 1-1/4" CU | Labels | None | 78% |
| Polyline | DHW 1" CU | Pipe Runs | None | 83% |
| Pipe Tag | DHW 1" CU | Labels | None | 78% |
| Polyline | DCW 3/4" CU | Pipe Runs | None | 88% |
| Pipe Tag | DCW 3/4" CU | Labels | None | 88% |
| Polyline | DHW 3/4" CU | Pipe Runs | None | 76% |
| Pipe Tag | DHW 3/4" CU | Labels | None | 76% |
| Polyline | DCW 2" CU | Pipe Runs | None | 72% |
| Pipe Tag | DCW 2" CU | Labels | None | 72% |
| Polyline | 3/4" CU | Pipe Runs | None | 60% |
| Pipe Tag | 3/4" CU | Labels | None | 60% |
| Tee | 1-1/4" × 3/4" Tee | Fittings | None | 84% |
| Tee (assumed) | 1" × 3/4" Tee (assumed) | Fittings | None | 66% |

| SUBJECT | LABEL | LAYER | STATUS | CONF. |
|---|---|---|---|---|
| Press coupling | 1" Press coupling | Fittings | None | 82% |
| Press coupling | 1-1/4" Press coupling | Fittings | None | 82% |
| Cap (stub-out) | 1" Cap (stub-out) | Fittings | None | 75% |
| Cap (stub-out) | 1-1/4" Cap (stub-out) | Fittings | None | 75% |
| Penetration — firestop sleeve | PEN-1 | Hangers & Supports | None | 90% |
| Penetration — firestop sleeve | PEN-2 | Hangers & Supports | None | 90% |
| Penetration — firestop sleeve | PEN-3 | Hangers & Supports | None | 86% |
| Wall strut channel | 1-5/8" Wall strut channel | Hangers & Supports | None | 85% |
| Dimension | 5" C-C | Dimensions | None | 72% |
| Dimension | 1'-5" | Dimensions | None | 70% |
| Stamp | AS-BUILT — Draft | Labels | None | 100% |
| Cloud+ | Verify firestop system | Issues | None | 80% |
| Cloud+ | Loose copper stub | Issues | None | 74% |
| Cloud+ | Insulation short of tee | Issues | None | 69% |




AS-BUILT ISOMETRIC — DOMESTIC WATER DROPS AT WALL PENETRATIONS

N.T.S. · DERIVED FROM PHOTO FT-04 · DIMENSIONS ESTIMATED

### GENERAL NOTES

1. TYPE L COPPER, PRESS FITTINGS U.N.O.
2. PENETRATIONS: SLEEVED, FIRESTOPPED — SYSTEM NO. TBD
3. R5 OVERHEAD 2" DCW NOT SHOWN (OCCLUDED)

### LEGEND

- DCW — Domestic Cold Water
- DHW — Domestic Hot Water
- CU — Copper (sugg.)
- Below 70% — verify

### REVISION CLOUDS

△1 Verify firestop system (Medium)
△2 Loose copper stub (High)
△3 Insulation short of tee (Low)

**FIELD TRACE**

MIMETIC TECHNOLOGY · MIMETICTECH.AI
110/20 SOFTWARE · PROTOTYPE

| | | | | |
|---|---|---|---|---|
| PROJECT: Sample Project — Mechanical Rough-In (DEMO-0142) | | | PREPARED BY: MIMETIC TECHNOLOGY | |
| DRAWING TITLE: AS-BUILT — DOMESTIC WATER DROPS AT WALL PENETRATIONS | | | LOCATION: Level 1 · Back-of-house wall W-12 | |
| SOURCE PHOTO: FT-04 · 2026-11-10 15:31 | DRAWN: FIELD TRACE AI | CHECKED: — | SCALE: N.T.S. | REV: A |
| STATUS: DRAFT — FOR REVIEW IN BLUEBEAM REVU 21.11 | | | SHEET: FT-04 | |

SAMPLE DATA · PUBLIC LICENSED PHOTO · NOT A CLIENT JOB PHOTO · NOT FOR CONSTRUCTION