
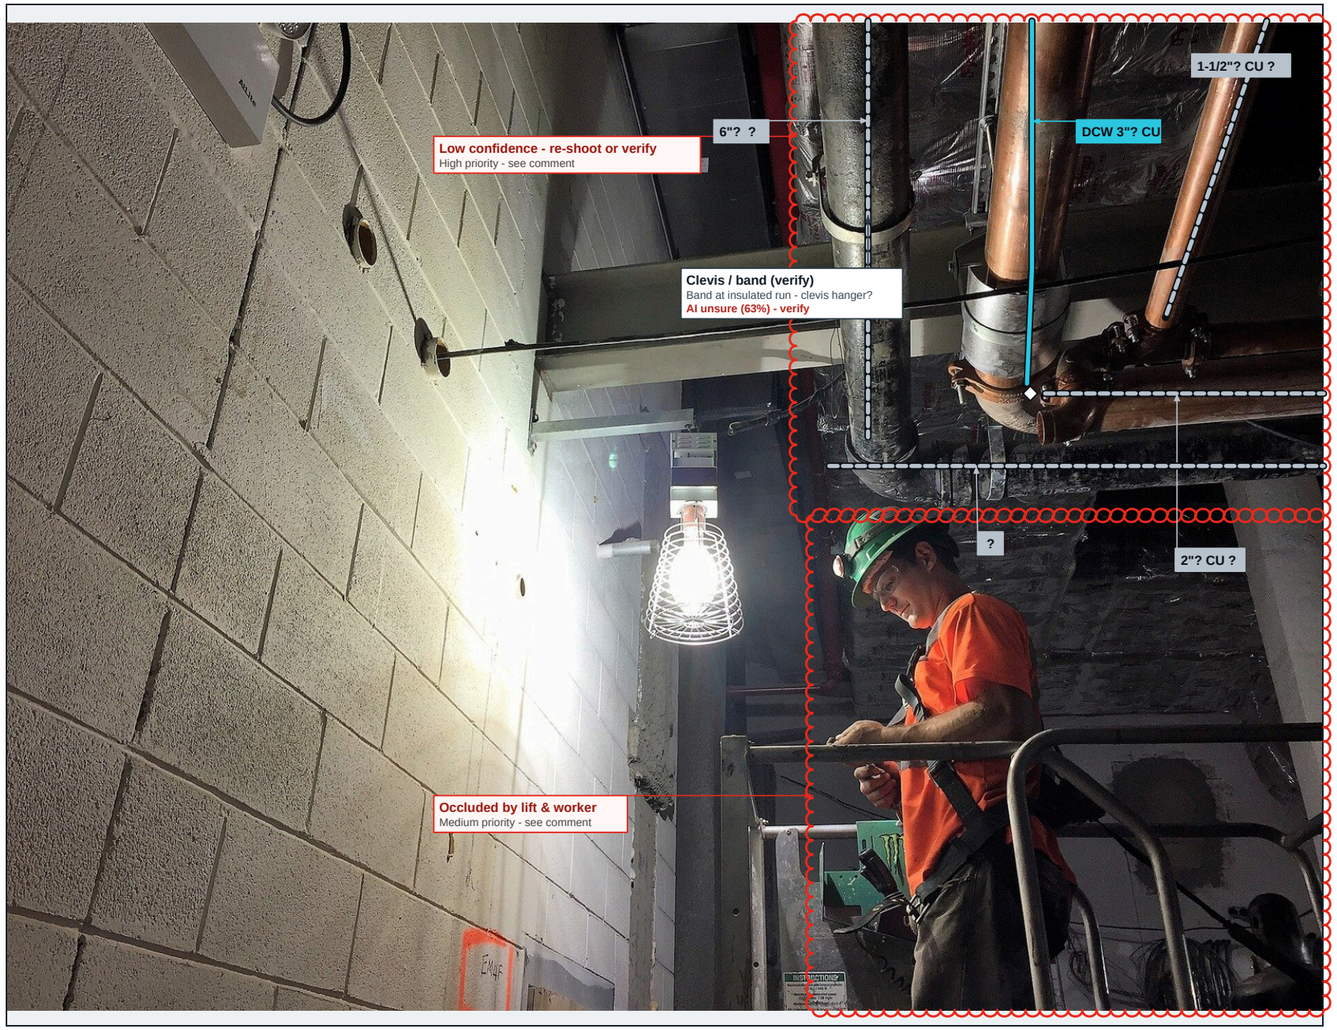



FIELD PHOTO FT-06 · LEVEL B1 · CORRIDOR D CEILING · 2026-11-11 16:48

MARKUPS = EDITABLE PDF ANNOTATIONS · AUTHOR: FIELD TRACE AI

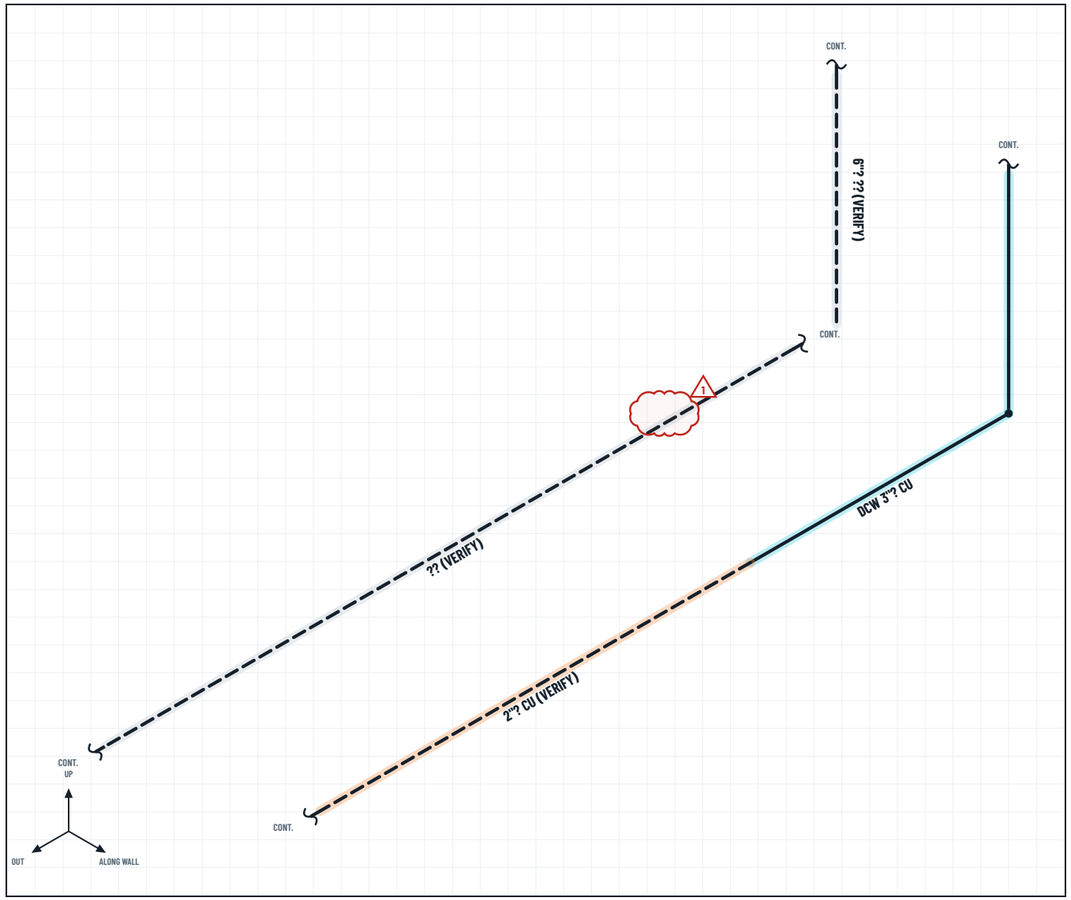


AS-BUILT ISOMETRIC — CEILING SPACE ABOVE CORRIDOR — LOW LIGHT

N.T.S. · DERIVED FROM PHOTO FT-06 · DIMENSIONS ESTIMATED

## MARKUP SUMMARY — 14 MARKUPS · 2 ISSUES · 10 BELOW 70%

| SUBJECT | LABEL | LAYER | STATUS | CONF. |
|---|---|---|---|---|
| Polyline | 6"? ?? | Pipe Runs | None | 66% |
| Pipe Tag | 6"? ?? | Labels | None | 50% |
| Polyline | DCW 3"? CU | Pipe Runs | None | 71% |
| Pipe Tag | DCW 3"? CU | Labels | None | 71% |
| Polyline | 2"? CU | Pipe Runs | None | 58% |
| Pipe Tag | 2"? CU | Labels | None | 58% |
| Polyline | 1-1/2"? CU | Pipe Runs | None | 61% |
| Pipe Tag | 1-1/2"? CU | Labels | None | 61% |
| Polyline | ?? | Pipe Runs | None | 52% |
| Pipe Tag | ?? | Labels | None | 50% |
| Clevis / band (verify) | Clevis / band (verify) | Hangers & Supports | None | 63% |
| Elbow (copper) | 3"? Elbow (copper) | Fittings | None | 60% |
| Cloud+ | Low confidence — re-shoot or verify | Issues | None | 95% |
| Cloud+ | Occluded by lift & worker | Issues | None | 90% |

## GENERAL NOTES

1. NOT ISSUED — HELD FOR REVIEW
2. DASHED RUNS BELOW 70% CONFIDENCE
3. SIZES UNVERIFIED (NO SCALE REFERENCE)

## LEGEND

- DCW — Domestic Cold Water
- CU — Copper (sugg.)
- ? — Not determinable (sugg.)
- Below 70% — verify

## REVISION CLOUDS

△1 Low confidence — re-shoot or verify (High)
△2 Occluded by lift & worker (Medium)

**FIELD TRACE**

MIMETIC TECHNOLOGY · MIMETICTECH.AI
110/20 SOFTWARE · PROTOTYPE

| | | | | |
|---|---|---|---|---|
| PROJECT: Sample Project — Mechanical Rough-In (DEMO-0142) | | | PREPARED BY: MIMETIC TECHNOLOGY | |
| DRAWING TITLE: AS-BUILT — CEILING SPACE ABOVE CORRIDOR — LOW LIGHT | | | LOCATION: Level B1 · Corridor D ceiling | |
| SOURCE PHOTO: FT-06 · 2026-11-11 16:48 | DRAWN: FIELD TRACE AI | CHECKED: — | SCALE: N.T.S. | REV: A |
| STATUS: HELD — NEEDS FIELD VERIFICATION | | | SHEET: FT-06 | |