
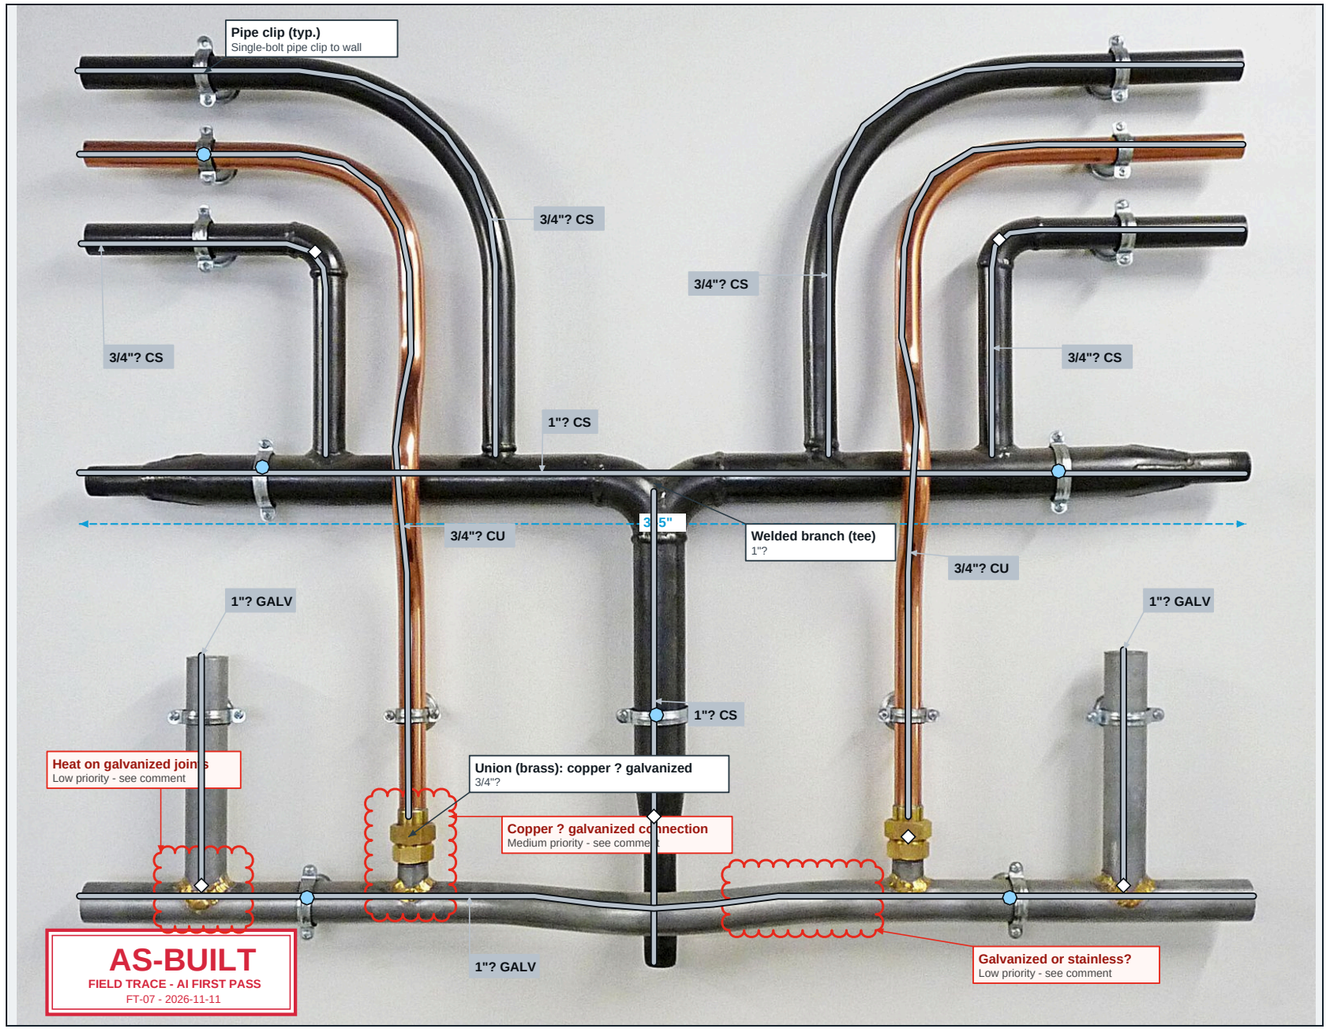



FIELD PHOTO FT-07 · PREFAB SHOP · MOCK-UP WALL · 2026-11-11 08:10

MARKUPS = EDITABLE PDF ANNOTATIONS · AUTHOR: FIELD TRACE AI

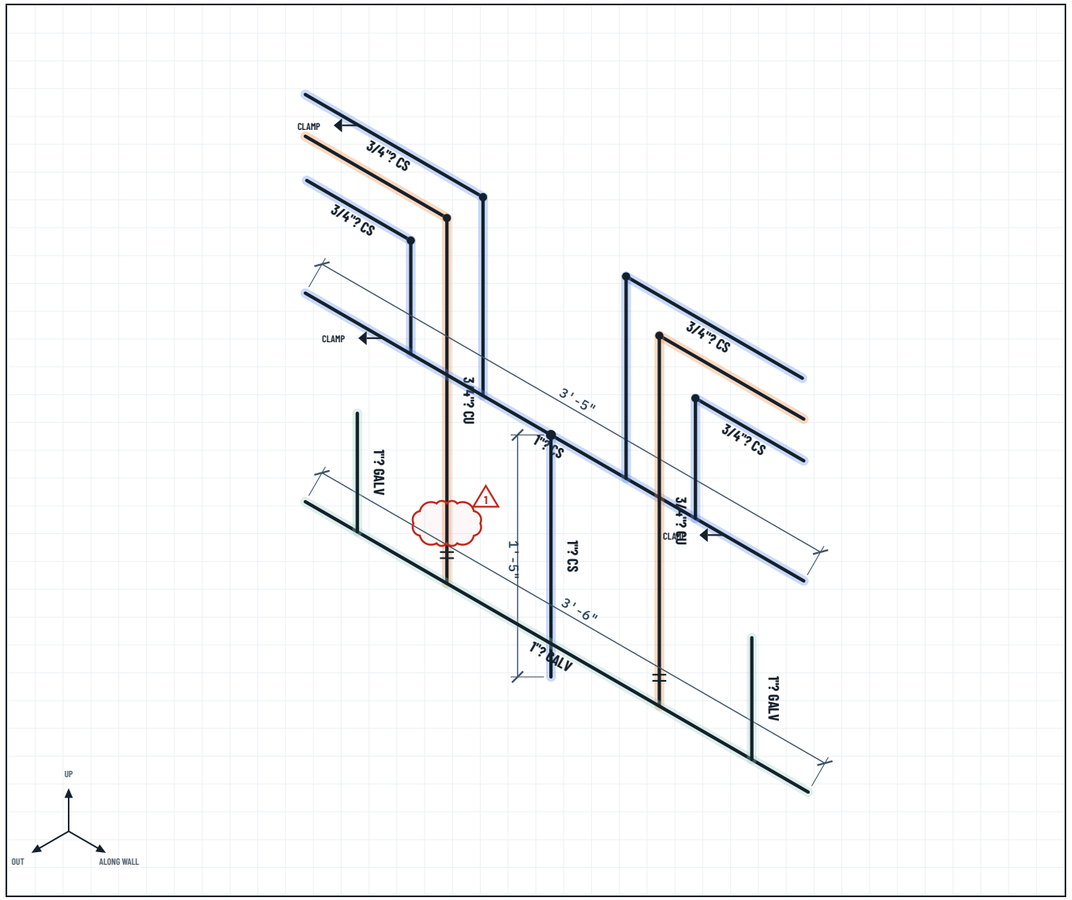


AS-BUILT ISOMETRIC — MIXED MATERIALS — BLACK STEEL, COPPER, GALVANIZED

N.T.S. · DERIVED FROM PHOTO FT-07 · DIMENSIONS ESTIMATED

## GENERAL NOTES

1. SCALE FROM COPPER OD (22 MM ASSUMED): LENGTHS APPROXIMATE
2. BENDS SHOWN AS CORNERS. BENT PIPE, NO FITTING
3. MATERIALS SUGGESTED: CS BLACK · CU · GALV. VERIFY

## LEGEND

- CS — Carbon steel (sugg.)
- CU — Copper (sugg.)
- GALV — Galvanized steel (sugg.)
- Below 70% — verify

## REVISION CLOUDS

△1 Copper ↔ galvanized connection (Medium)
△2 Heat on galvanized joints (Low)
△3 Galvanized or stainless? (Low)

## MARKUP SUMMARY — 42 MARKUPS · 3 ISSUES · 2 BELOW 70%

| SUBJECT | LABEL | LAYER | STATUS | CONF. |
|---|---|---|---|---|
| Polyline | 3/4"? CS | Pipe Runs | None | 90% |
| Pipe Tag | 3/4"? CS | Labels | None | 90% |
| Polyline | 3/4"? CU | Pipe Runs | None | 92% |
| Pipe Tag | 3/4"? CU | Labels | None | 92% |
| Polyline | 3/4"? CS | Pipe Runs | None | 90% |
| Pipe Tag | 3/4"? CS | Labels | None | 88% |
| Polyline | 1"? CS | Pipe Runs | None | 93% |
| Pipe Tag | 1"? CS | Labels | None | 90% |
| Polyline | 3/4"? CS | Pipe Runs | None | 90% |
| Pipe Tag | 3/4"? CS | Labels | None | 90% |
| Polyline | 3/4"? CU | Pipe Runs | None | 91% |
| Pipe Tag | 3/4"? CU | Labels | None | 91% |
| Polyline | 3/4"? CS | Pipe Runs | None | 90% |
| Pipe Tag | 3/4"? CS | Labels | None | 88% |
| Polyline | 1"? CS | Pipe Runs | None | 88% |
| Pipe Tag | 1"? CS | Labels | None | 88% |
| Polyline | 1"? GALV | Pipe Runs | None | 86% |
| Pipe Tag | 1"? GALV | Labels | None | 74% |
| Polyline | 1"? GALV | Pipe Runs | None | 88% |
| Pipe Tag | 1"? GALV | Labels | None | 72% |
| Polyline | 1"? GALV | Pipe Runs | None | 88% |

| SUBJECT | LABEL | LAYER | STATUS | CONF. |
|---|---|---|---|---|
| Pipe Tag | 1"? GALV | Labels | None | 72% |
| Welded branch (tee) | 1"? Welded branch (tee) | Fittings | None | 88% |
| 90° elbow (welded) | 3/4"? 90° elbow (welded) | Fittings | None | 86% |
| 90° elbow (welded) | 3/4"? 90° elbow (welded) | Fittings | None | 86% |
| Concentric reducer (swaged) | Concentric reducer (swaged) | Fittings | None | 80% |
| Union (brass): copper → galvanized | 3/4"? Union (brass): copper → galvanized | Fittings | None | 85% |
| Union (brass): copper → galvanized | 3/4"? Union (brass): copper → galvanized | Fittings | None | 85% |
| Brazed branch joint | Brazed branch joint | Fittings | None | 78% |
| Brazed branch joint | Brazed branch joint | Fittings | None | 78% |
| Pipe clip (typ.) | Pipe clip (typ.) | Hangers & Supports | None | 90% |
| Pipe clip | Pipe clip | Hangers & Supports | None | 88% |
| Pipe clip | Pipe clip | Hangers & Supports | None | 88% |
| Pipe clip | Pipe clip | Hangers & Supports | None | 88% |
| Pipe clip | Pipe clip | Hangers & Supports | None | 88% |
| Pipe clip | Pipe clip | Hangers & Supports | None | 86% |
| Pipe clip | Pipe clip | Hangers & Supports | None | 86% |
| Dimension | 3'-5" | Dimensions | None | 66% |
| Stamp | AS-BUILT — Draft | Labels | None | 100% |
| Cloud+ | Copper ↔ galvanized connection | Issues | None | 82% |
| Cloud+ | Heat on galvanized joints | Issues | None | 70% |
| Cloud+ | Galvanized or stainless? | Issues | None | 66% |

## FIELD TRACE

MIMETIC TECHNOLOGY · MIMETICTECH.AI
110/20 SOFTWARE · PROTOTYPE

| | | | |
|---|---|---|---|
| PROJECT: Sample Project — Mechanical Rough-In (DEMO-0142) | | | PREPARED BY: MIMETIC TECHNOLOGY |
| DRAWING TITLE: AS-BUILT — MIXED MATERIALS — BLACK STEEL, COPPER, GALVANIZED | | | LOCATION: Prefab shop · mock-up wall |
| SOURCE PHOTO: FT-07 · 2026-11-11 08:10 | DRAWN: FIELD TRACE AI | CHECKED: — | SCALE: N.T.S. / REV: A |
| STATUS: DRAFT — FOR REVIEW IN BLUEBEAM REVU 21.11 | | | SHEET: FT-07 |

SAMPLE DATA · PUBLIC LICENSED PHOTO · NOT A CLIENT JOB PHOTO · NOT FOR CONSTRUCTION