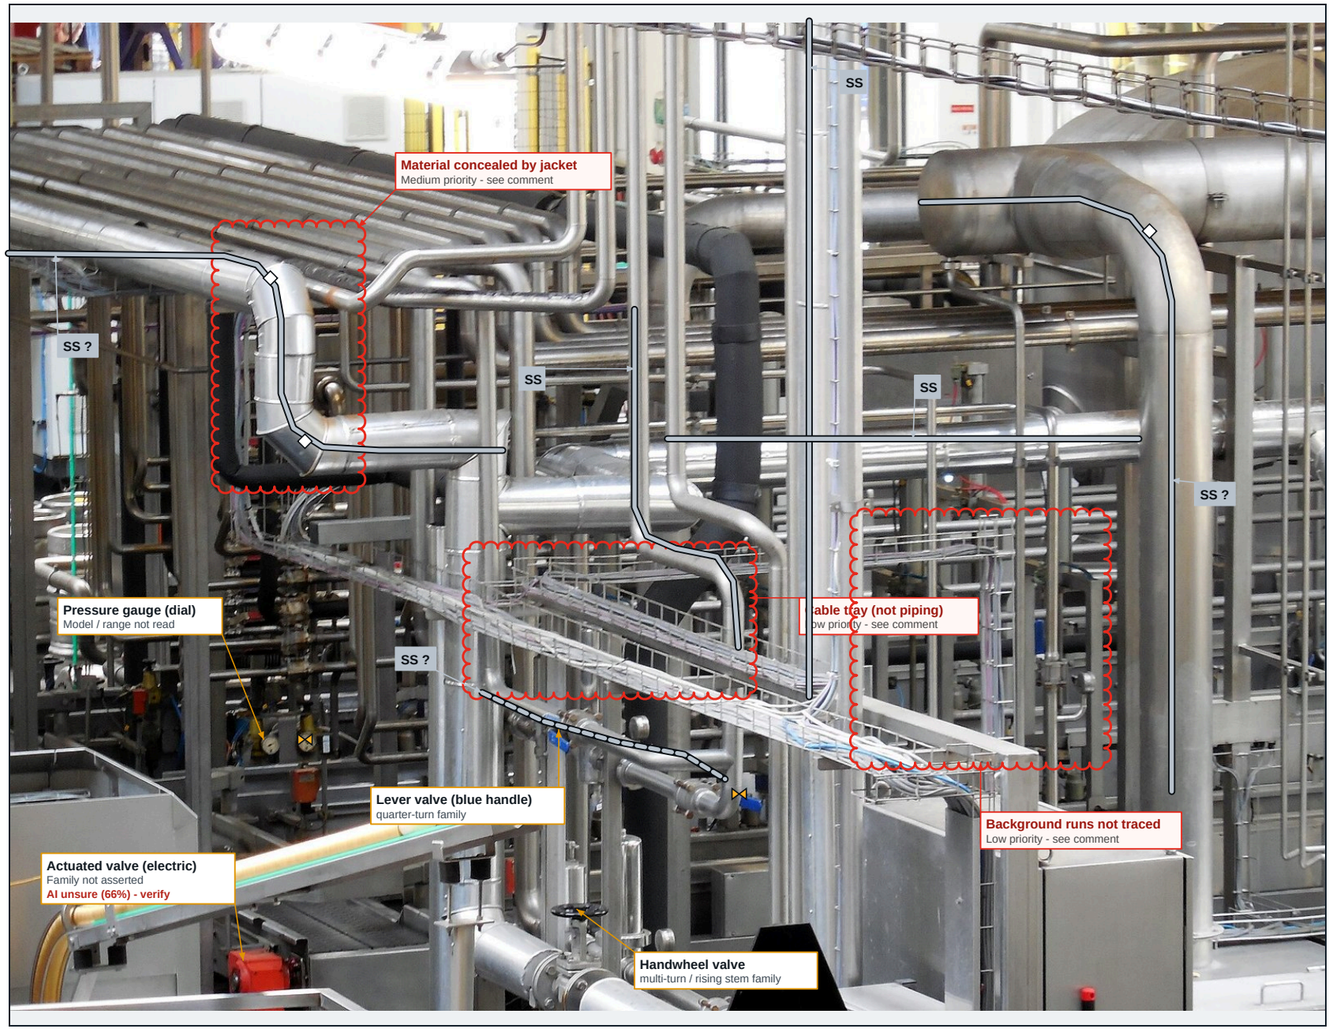


FIELD PHOTO FT-08 · PROCESS AREA · UTILITY RACK · 2026-11-11 10:05

MARKUPS = EDITABLE PDF ANNOTATIONS · AUTHOR: FIELD TRACE AI

MARKUP SUMMARY — 24 MARKUPS · 3 ISSUES · 6 BELOW 70%

SUBJECT	LABEL	LAYER	STATUS	CONF.
Polyline	SS?	Pipe Runs	None	84%
Pipe Tag	SS?	Labels	None	50%
Polyline	SS?	Pipe Runs	None	82%
Pipe Tag	SS?	Labels	None	50%
Polyline	SS	Pipe Runs	None	80%
Pipe Tag	SS	Labels	None	80%
Polyline	SS	Pipe Runs	None	70%
Pipe Tag	SS	Labels	None	70%
Polyline	SS	Pipe Runs	None	74%
Pipe Tag	SS	Labels	None	74%
Polyline	SS?	Pipe Runs	None	62%
Pipe Tag	SS?	Labels	None	62%

SUBJECT	LABEL	LAYER	STATUS	CONF.
Lever valve (blue handle)	Lever valve (blue handle)	Valves & Instruments	None	74%
Lever valve (blue handle)	Lever valve (blue handle)	Valves & Instruments	None	72%
Handwheel valve	Handwheel valve	Valves & Instruments	None	70%
Actuated valve (electric)	Actuated valve (electric)	Valves & Instruments	None	66%
Pressure gauge (dial)	Pressure gauge (dial)	Valves & Instruments	None	70%
Pressure gauge (dial)	Pressure gauge (dial)	Valves & Instruments	None	66%
Elbow (jacketed)	Elbow (jacketed)	Fittings	None	84%
Elbow (jacketed)	Elbow (jacketed)	Fittings	None	82%
Elbow (jacketed)	Elbow (jacketed)	Fittings	None	82%
Cloud+	Material concealed by jacket	Issues	None	80%
Cloud+	Cable tray (not piping)	Issues	None	75%
Cloud+	Background runs not traced	Issues	None	70%

AS-BUILT ISOMETRIC: HELD

Not drafted: dense rack, no scale reference. Confirm one bare-pipe size in the workspace and lengths follow.

Run	Material (sugg.)	Size	OD	Schedule (sugg.)
R1	SS ?	?	Jacket OD only	—
R2	SS ?	?	Jacket OD only	—
R3	SS	?	NPS (S) or OD tube convention · needs a scale	Sch 10S
R4	SS	?	NPS (S) or OD tube convention · needs a scale	Sch 10S
R5	SS	?	NPS (S) or OD tube convention · needs a scale	Sch 10S
R6	SS ?	?	NPS (S) or OD tube convention · needs a scale	—

Wall thickness is not visible from a photo. Rating and corrosion allowance need verification.

RUN SCHEDULE — PROCESS RACK — STAINLESS AND JACKETED LINES

NO ISO DRAFTED · MATERIALS AND SCHEDULES SUGGESTED

GENERAL NOTES

1. Not drafted: dense rack, no scale reference. Confirm one bare-pipe size in the workspace and lengths follow.
2. SCHEDULES ARE SUGGESTED. WALL IS NOT VISIBLE IN A PHOTO. VERIFY

LEGEND

SS — Stainless steel (sugg.)

Below 70% — verify

REVISION CLOUDS

△1 Material concealed by jacket (Medium)

△2 Cable tray (not piping) (Low)

△3 Background runs not traced (Low)

FIELD TRACE

MIMETIC TECHNOLOGY · MIMETICTECH.AI
110/20 SOFTWARE · PROTOTYPE

PROJECT: Sample Project — Mechanical Rough-In (DEMO-0142)			PREPARED BY: MIMETIC TECHNOLOGY	
DRAWING TITLE: AS-BUILT — PROCESS RACK — STAINLESS AND JACKETED LINES			LOCATION: Process area · utility rack	
SOURCE PHOTO: FT-08 · 2026-11-11 10:05	DRAWN: FIELD TRACE AI	CHECKED: —	SCALE: N.T.S.	REV: A
STATUS: DRAFT — FOR REVIEW IN BLUEBEAM REVU 21.11			SHEET: FT-08	