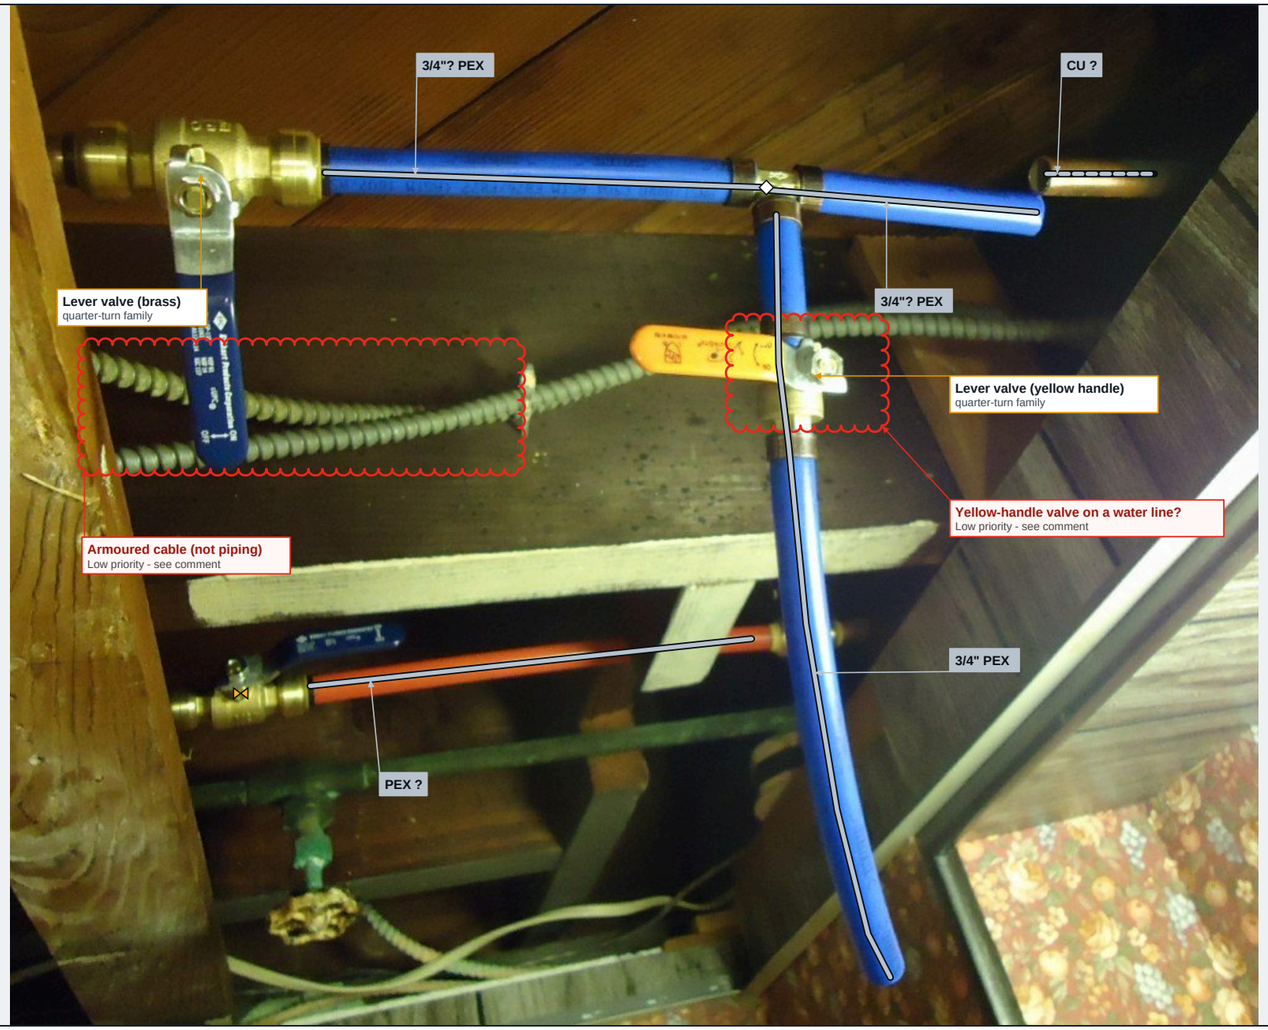


FIELD PHOTO FT-09 · RESIDENTIAL · BASEMENT CEILING · 2026-11-11 14:22

MARKUPS = EDITABLE PDF ANNOTATIONS · AUTHOR: FIELD TRACE AI

AS-BUILT ISOMETRIC: HELD

Not drafted as an iso. Lengths come from the assumed 3/4" PEX scale.

Run	Material (sugg.)	Size	OD	Schedule (sugg.)
R1	PEX	3/4"?	0.875"?	SDR 9
R2	PEX	3/4"?	0.875"?	SDR 9
R3	CU ?	?	CTS convention · needs a scale	—
R4	PEX	3/4"	0.875"	SDR 9
R5	PEX ?	?	CTS convention · needs a scale	SDR 9

Wall thickness is not visible from a photo. Rating and corrosion allowance need verification.

RUN SCHEDULE — PEX AND COPPER — BASEMENT CEILING

NO ISO DRAFTED · MATERIALS AND SCHEDULES SUGGESTED

MARKUP SUMMARY — 16 MARKUPS · 2 ISSUES · 4 BELOW 70%

SUBJECT	LABEL	LAYER	STATUS	CONF.
Polyline	3/4"? PEX	Pipe Runs	None	86%
Pipe Tag	3/4"? PEX	Labels	None	78%
Polyline	3/4"? PEX	Pipe Runs	None	82%
Pipe Tag	3/4"? PEX	Labels	None	76%
Polyline	CU?	Pipe Runs	None	60%
Pipe Tag	CU?	Labels	None	55%
Polyline	3/4" PEX	Pipe Runs	None	85%
Pipe Tag	3/4" PEX	Labels	None	80%
Polyline	PEX?	Pipe Runs	None	72%
Pipe Tag	PEX?	Labels	None	64%
Lever valve (brass)	Lever valve (brass)	Valves & Instruments	None	84%
Lever valve (yellow handle)	Lever valve (yellow handle)	Valves & Instruments	None	80%
Lever valve (brass)	Lever valve (brass)	Valves & Instruments	None	70%
Tee (brass, crimp)	3/4"? Tee (brass, crimp)	Fittings	None	84%
Cloud+	Armoured cable (not piping)	Issues	None	80%
Cloud+	Yellow-handle valve on a water line?	Issues	None	60%

GENERAL NOTES

1. Not drafted as an iso. Lengths come from the assumed 3/4" PEX scale.
2. SCHEDULES ARE SUGGESTED. WALL IS NOT VISIBLE IN A PHOTO. VERIFY

LEGEND

- CU — Copper (sugg.)
- COMP — Composite & plastic (sugg.)
- Below 70% — verify

REVISION CLOUDS

△1 Armoured cable (not piping) (Low)
△2 Yellow-handle valve on a water line? (Low)

FIELD TRACE

MIMETIC TECHNOLOGY · MIMETICTECH.AI
110/20 SOFTWARE · PROTOTYPE

PROJECT: Sample Project — Mechanical Rough-In (DEMO-0142)			PREPARED BY: MIMETIC TECHNOLOGY	
DRAWING TITLE: AS-BUILT — PEX AND COPPER — BASEMENT CEILING			LOCATION: Residential · basement ceiling	
SOURCE PHOTO: FT-09 · 2026-11-11 14:22	DRAWN: FIELD TRACE AI	CHECKED: —	SCALE: N.T.S.	REV: A
STATUS: DRAFT — FOR REVIEW IN BLUEBEAM REVU 21.11			SHEET: FT-09	