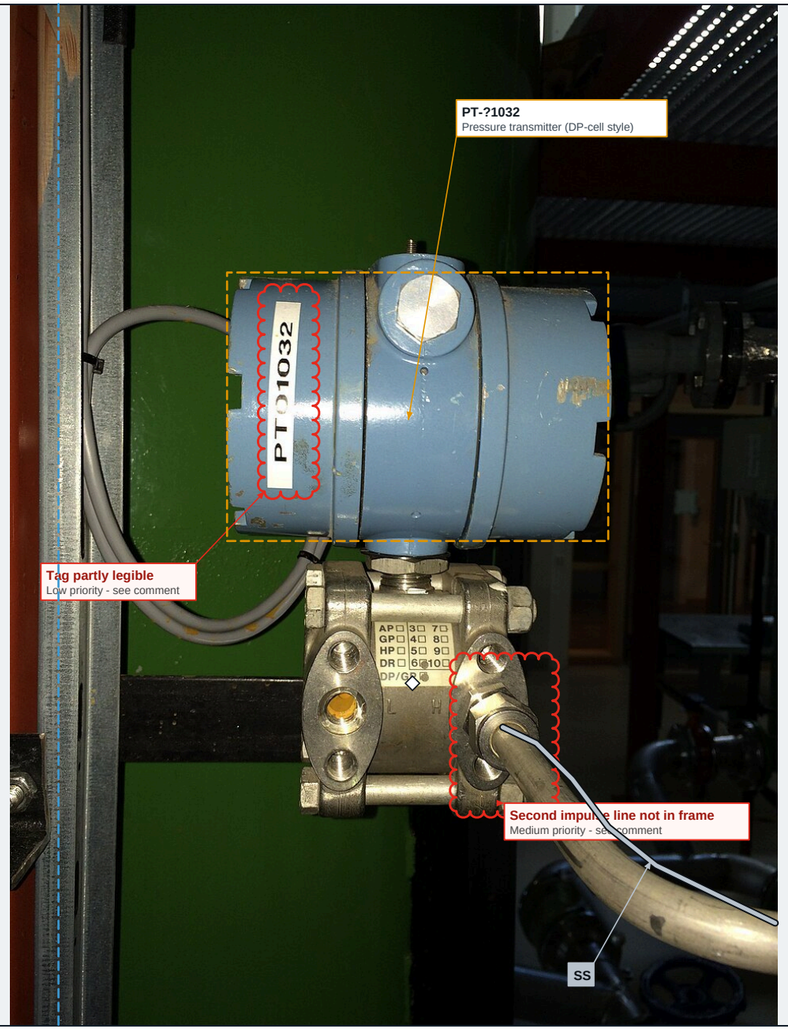


FIELD PHOTO FT-11 · INSTRUMENT STAND · 2026-11-11 16:02

MARKUPS = EDITABLE PDF ANNOTATIONS · AUTHOR: FIELD TRACE AI

MARKUP SUMMARY — 7 MARKUPS · 2 ISSUES · 1 BELOW 70%

SUBJECT	LABEL	LAYER	STATUS	CONF.
Polyline	SS	Pipe Runs	None	82%
Pipe Tag	SS	Labels	None	74%
Pressure transmitter (DP-cell style)	PT-?1032	Valves & Instruments	None	84%
Process flange (sensor module)	Process flange (sensor module)	Fittings	None	80%

SUBJECT	LABEL	LAYER	STATUS	CONF.
Strut channel (stand)	Strut channel (stand)	Hangers & Supports	None	80%
Cloud+	Second impulse line not in frame	Issues	None	66%
Cloud+	Tag partly legible	Issues	None	80%

AS-BUILT ISOMETRIC: HELD

Instrument hook-up. Not drafted as an iso.

Run	Material (sugg.)	Size	OD	Schedule (sugg.)
R1	SS	?	Tube OD convention · needs a scale	—

Wall thickness is not visible from a photo. Rating and corrosion allowance need verification.

RUN SCHEDULE — PRESSURE TRANSMITTER ON STAINLESS IMPULSE TUBING

NO ISO DRAFTED · MATERIALS AND SCHEDULES SUGGESTED

GENERAL NOTES

1. Instrument hook-up. Not drafted as an iso.
2. SCHEDULES ARE SUGGESTED. WALL IS NOT VISIBLE IN A PHOTO. VERIFY

LEGEND

SS — Stainless steel (sugg.)

Below 70% — verify

REVISION CLOUDS

△1 Second impulse line not in frame (Medium)

△2 Tag partly legible (Low)

FIELD TRACE

MIMETIC TECHNOLOGY · MIMETICTECH.AI
110/20 SOFTWARE · PROTOTYPE

PROJECT: Sample Project — Mechanical Rough-In (DEMO-0142)			PREPARED BY: MIMETIC TECHNOLOGY	
DRAWING TITLE: AS-BUILT — PRESSURE TRANSMITTER ON STAINLESS IMPULSE TUBING			LOCATION: Instrument stand	
SOURCE PHOTO: FT-11 · 2026-11-11 16:02	DRAWN: FIELD TRACE AI	CHECKED: —	SCALE: N.T.S.	REV: A
STATUS: DRAFT — FOR REVIEW IN BLUEBEAM REVU 21.11			SHEET: FT-11	

SAMPLE DATA · PUBLIC LICENSED PHOTO · NOT A CLIENT JOB PHOTO · NOT FOR CONSTRUCTION