
FIELD TRACE


ANNOTATED FIELD PHOTO + AS-BUILT ISOMETRIC · FT-01

MIMETIC TECHNOLOGY PROTOTYPE · PREPARED FOR SCHILKE CONSTRUCTION · **SAMPLE DATA — NOT FOR CONSTRUCTION**

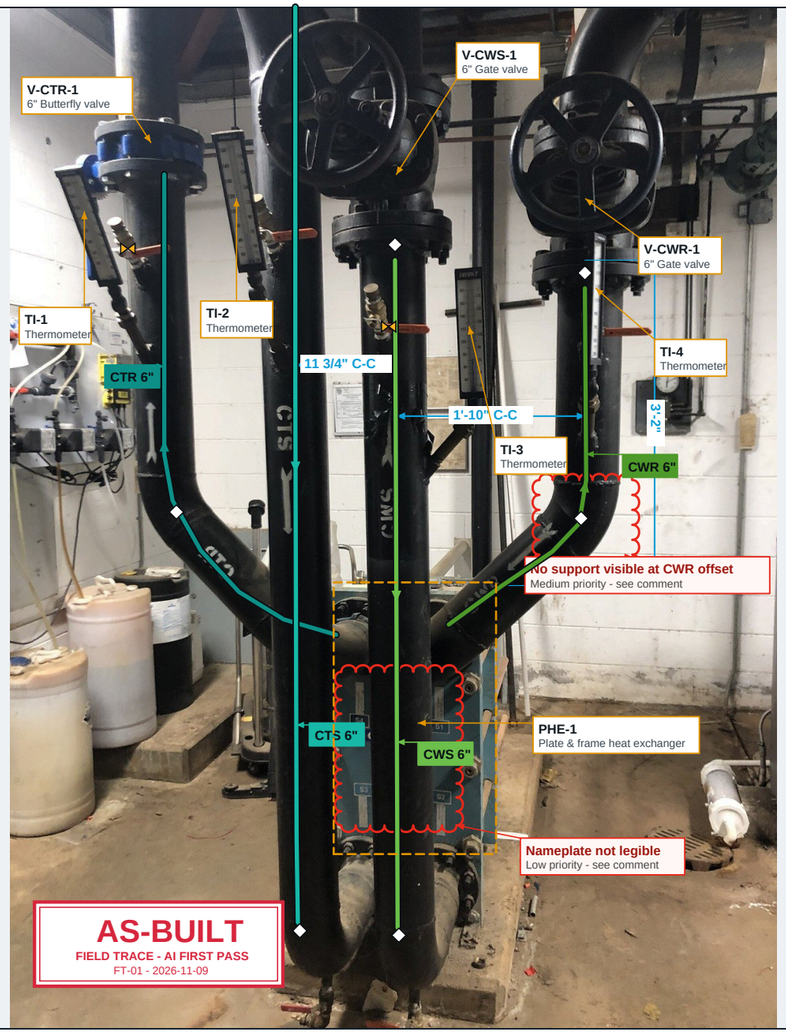

FIELD PHOTO FT-01 · MECH. RM B-104 · NORTH WALL · 2026-11-09 07:42

MARKUPS = EDITABLE PDF ANNOTATIONS · AUTHOR: FIELD TRACE AI

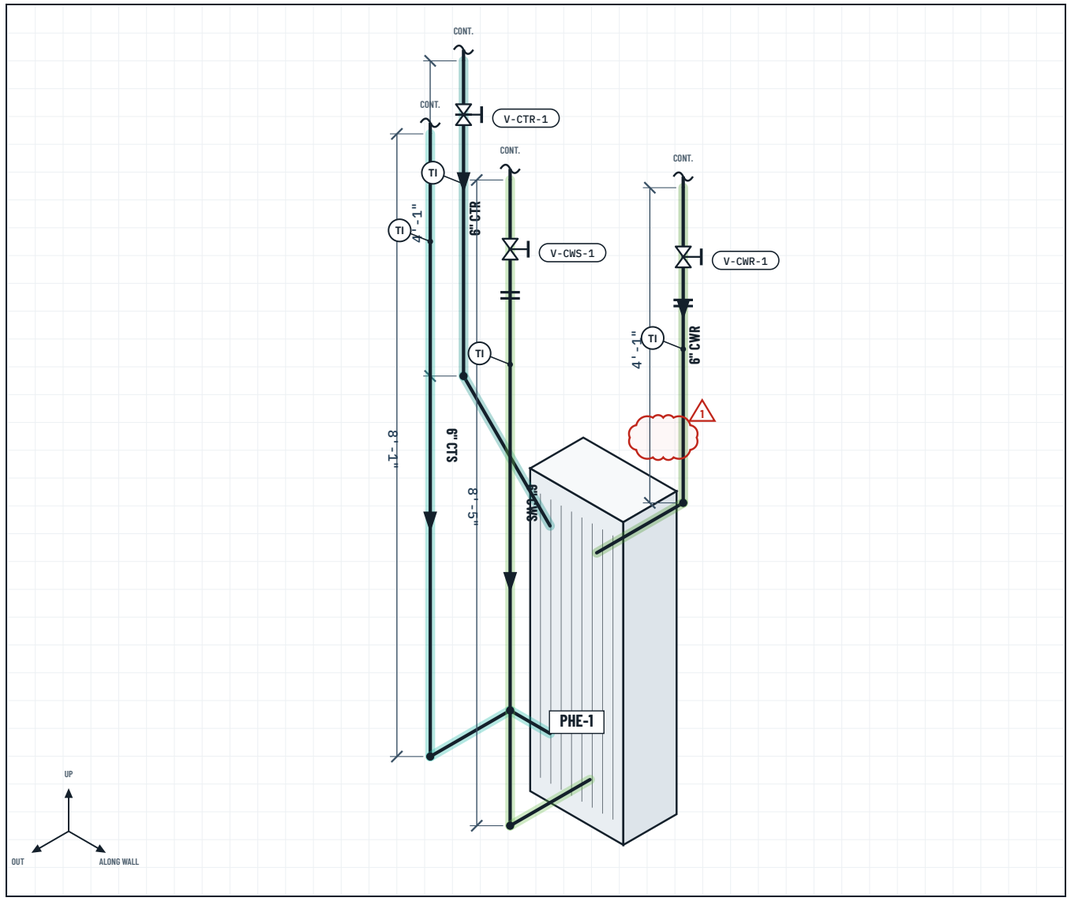

AS-BUILT ISOMETRIC — PLATE HX-1 — TOWER / CONDENSER WATER

N.T.S. · DERIVED FROM PHOTO FT-01 · DIMENSIONS ESTIMATED

MARKUP SUMMARY — 30 MARKUPS · 2 ISSUES · 0 BELOW 70%

SUBJECT	LABEL	LAYER	STATUS	CONF.
Polyline	6" CTR	Pipe Runs	None	95%
Pipe Tag	CTR 6"	Labels	None	95%
Polyline	6" CTS	Pipe Runs	None	93%
Pipe Tag	CTS 6"	Labels	None	93%
Polyline	6" CWS	Pipe Runs	None	96%
Pipe Tag	CWS 6"	Labels	None	96%
Polyline	6" CWR	Pipe Runs	None	94%
Pipe Tag	CWR 6"	Labels	None	94%
Gate valve	V-CWS-1	Valves & Devices	None	92%
Gate valve	V-CWR-1	Valves & Devices	None	91%
Butterfly valve	V-CTR-1	Valves & Devices	None	88%
Thermometer	TI-1	Valves & Devices	None	86%
Thermometer	TI-2	Valves & Devices	None	87%
Thermometer	TI-3	Valves & Devices	None	89%
Thermometer	TI-4	Valves & Devices	None	84%
Ball valve (drain/vent)	3/4" Ball valve (drain/vent)	Valves & Devices	None	79%
Ball valve (drain/vent)	3/4" Ball valve (drain/vent)	Valves & Devices	None	77%
Flange pair	6" Flange pair	Fittings	None	93%
Flange pair	6" Flange pair	Fittings	None	93%
45° elbow	6" 45° elbow	Fittings	None	90%
45° elbow	6" 45° elbow	Fittings	None	88%
90° LR elbow	6" 90° LR elbow	Fittings	None	71%
90° LR elbow	6" 90° LR elbow	Fittings	None	70%
Plate & frame heat exchanger	PHE-1	Valves & Devices	None	90%
Dimension	1'-10" C-C	Dimensions	None	82%
Dimension	11 3/4" C-C	Dimensions	None	80%
Dimension	3'-2"	Dimensions	None	74%
Stamp	AS-BUILT — Draft	Labels	None	100%
Cloud+	No support visible at CWR offset	Issues	None	72%
Cloud+	Nameplate not legible	Issues	None	90%

GENERAL NOTES

1. ALL PIPING 6" SCH 40 CS, 150# RF FLANGED U.N.O.
2. ELEVATIONS ESTIMATED FROM PHOTO — VERIFY IN FIELD
3. STENCILS READ: CTS · CTR · CWS · CWR

LEGEND

- CTR — Cooling Tower Return
- CTS — Cooling Tower Supply
- CWS — Condenser Water Supply
- CWR — Condenser Water Return
- Below 70% — verify

REVISION CLOUDS

△1 No support visible at CWR offset (Medium)
△2 Nameplate not legible (Low)

FIELD TRACE

MIMETIC TECHNOLOGY · MIMETICTECH.AI
80/20 SOFTWARE · PROTOTYPE

PROJECT: Sample Project — Mechanical Rough-In (DEMO-0142)			PREPARED FOR: Schilke Construction	
DRAWING TITLE: AS-BUILT — PLATE HX-1 — TOWER / CONDENSER WATER			LOCATION: Mech. Rm B-104 · North wall	
SOURCE PHOTO: FT-01 · 2026-11-09 07:42	DRAWN: FIELD TRACE AI	CHECKED: —	SCALE: N.T.S.	REV: A
STATUS: DRAFT — FOR REVIEW IN BLUEBEAM REVU 21.11			SHEET: FT-01	

SAMPLE DATA · PUBLIC LICENSED PHOTO · NOT A SCHILKE JOB PHOTO · NOT FOR CONSTRUCTION