
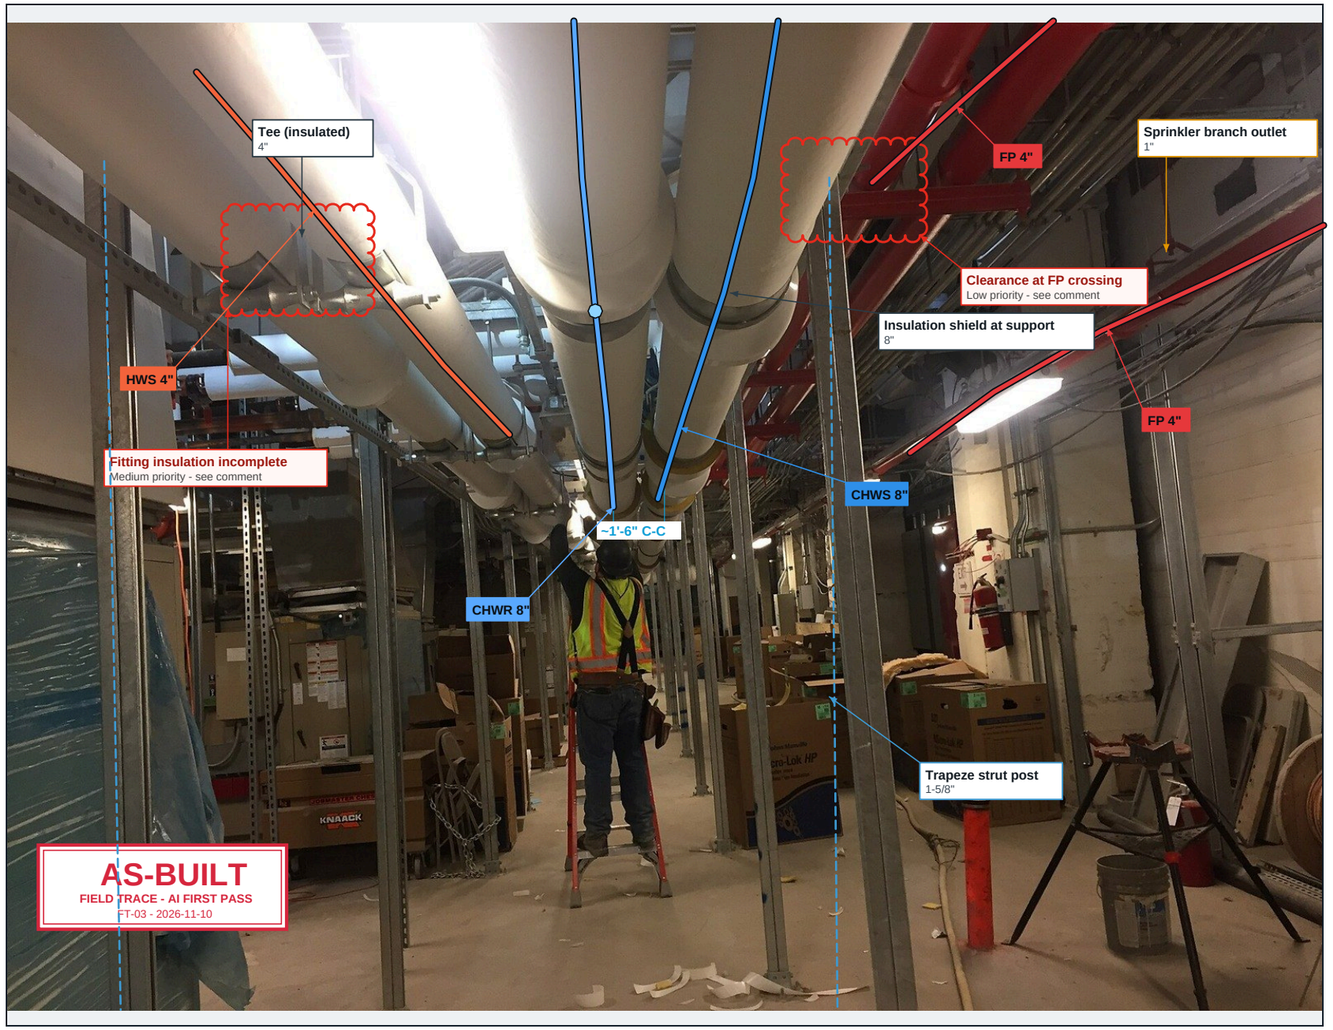


FIELD PHOTO FT-03 · LEVEL B1 · EAST SERVICE CORRIDOR · 2026-11-10 13:05

MARKUPS = EDITABLE PDF ANNOTATIONS · AUTHOR: FIELD TRACE AI

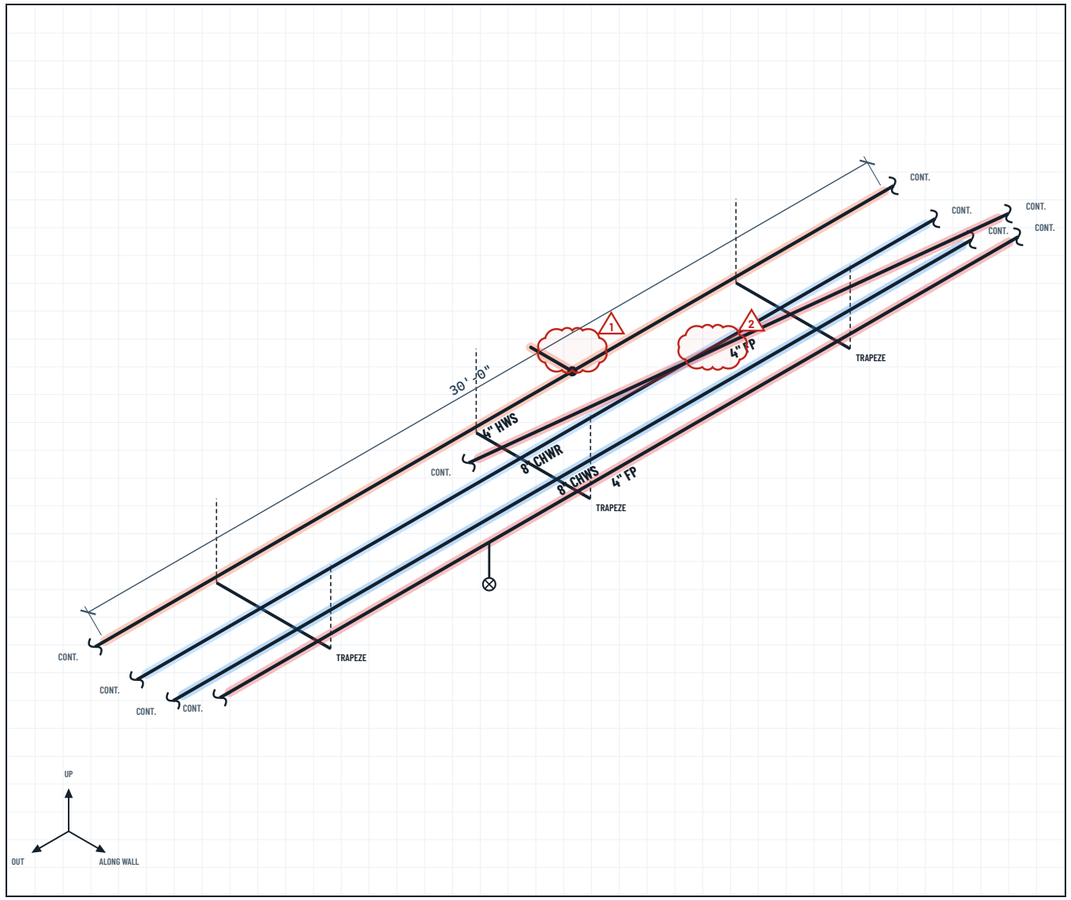

AS-BUILT ISOMETRIC — OVERHEAD MAINS — EAST SERVICE CORRIDOR

N.T.S. · DERIVED FROM PHOTO FT-03 · DIMENSIONS ESTIMATED

MARKUP SUMMARY — 20 MARKUPS · 2 ISSUES · 2 BELOW 70%

SUBJECT	LABEL	LAYER	STATUS	CONF.
Polyline	8" CHWS	Pipe Runs	None	88%
Pipe Tag	CHWS 8"	Labels	None	88%
Polyline	8" CHWR	Pipe Runs	None	86%
Pipe Tag	CHWR 8"	Labels	None	86%
Polyline	4" HWS	Pipe Runs	None	79%
Pipe Tag	HWS 4"	Labels	None	79%
Polyline	4" FP	Pipe Runs	None	90%
Pipe Tag	FP 4"	Labels	None	90%
Polyline	4" FP	Pipe Runs	None	84%
Pipe Tag	FP 4"	Labels	None	84%

SUBJECT	LABEL	LAYER	STATUS	CONF.
Insulation shield at support	8" Insulation shield at support	Hangers & Supports	None	83%
Insulation shield at support	8" Insulation shield at support	Hangers & Supports	None	80%
Trapeze strut post	1-5/8" Trapeze strut post	Hangers & Supports	None	86%
Trapeze strut post	1-5/8" Trapeze strut post	Hangers & Supports	None	84%
Sprinkler branch outlet	1" Sprinkler branch outlet	Valves & Devices	None	74%
Tee (insulated)	4" Tee (insulated)	Fittings	None	70%
Dimension	~1'-6" C-C	Dimensions	None	62%
Stamp	AS-BUILT — Draft	Labels	None	100%
Cloud+	Fitting insulation incomplete	Issues	None	71%
Cloud+	Clearance at FP crossing	Issues	None	66%

GENERAL NOTES

1. RUN LENGTHS FROM ASSUMED 10'-0" SUPPORT SPACING
2. INSULATION: CHW 2", HW 1-1/2" (PER SPEC — VERIFY)
3. FP SHOWN FOR COORDINATION ONLY

LEGEND

- CHWS — Chilled Water Supply
- CHWR — Chilled Water Return
- HWS — Heating Hot Water Supply
- FP — Fire Protection
- Below 70% — verify

REVISION CLOUDS

△1 Fitting insulation incomplete (Medium)
△2 Clearance at FP crossing (Low)

FIELD TRACE

MIMETIC TECHNOLOGY · MIMETICTECH.AI
80/20 SOFTWARE · PROTOTYPE

PROJECT: Sample Project — Mechanical Rough-In (DEMO-0142)			PREPARED FOR: Schilke Construction	
DRAWING TITLE: AS-BUILT — OVERHEAD MAINS — EAST SERVICE CORRIDOR			LOCATION: Level B1 · East service corridor	
SOURCE PHOTO: FT-03 · 2026-11-10 13:05	DRAWN: FIELD TRACE AI	CHECKED: —	SCALE: N.T.S.	REV: A
STATUS: DRAFT — FOR REVIEW IN BLUEBEAM REVU 21.11			SHEET: FT-03	

SAMPLE DATA · PUBLIC LICENSED PHOTO · NOT A SCHILKE JOB PHOTO · NOT FOR CONSTRUCTION