
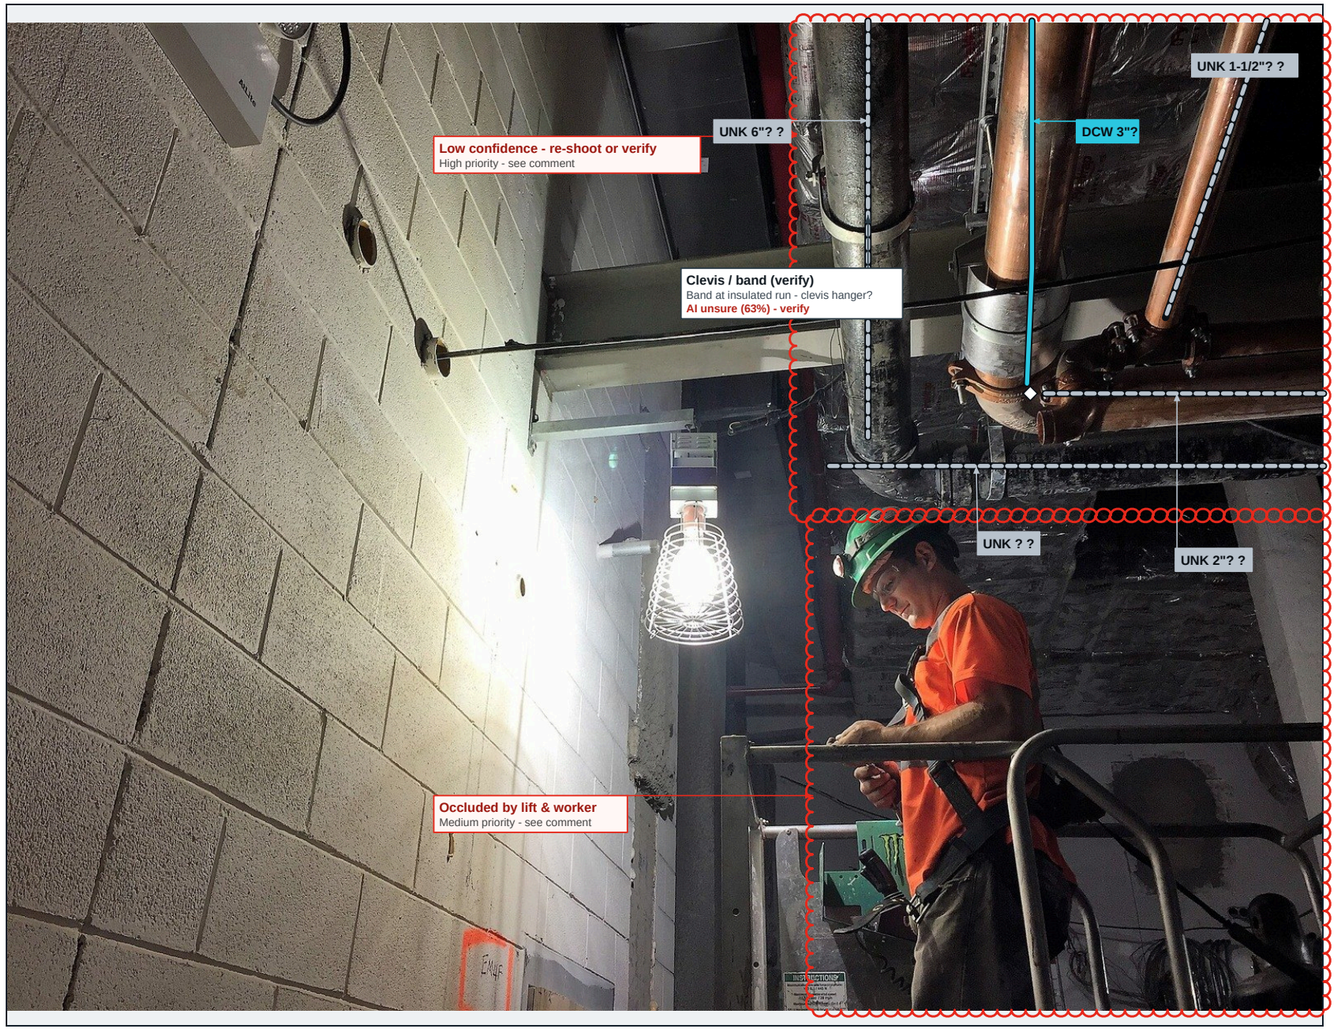


FIELD PHOTO FT-06 · LEVEL B1 · CORRIDOR D CEILING · 2026-11-11 16:48

MARKUPS = EDITABLE PDF ANNOTATIONS · AUTHOR: FIELD TRACE AI

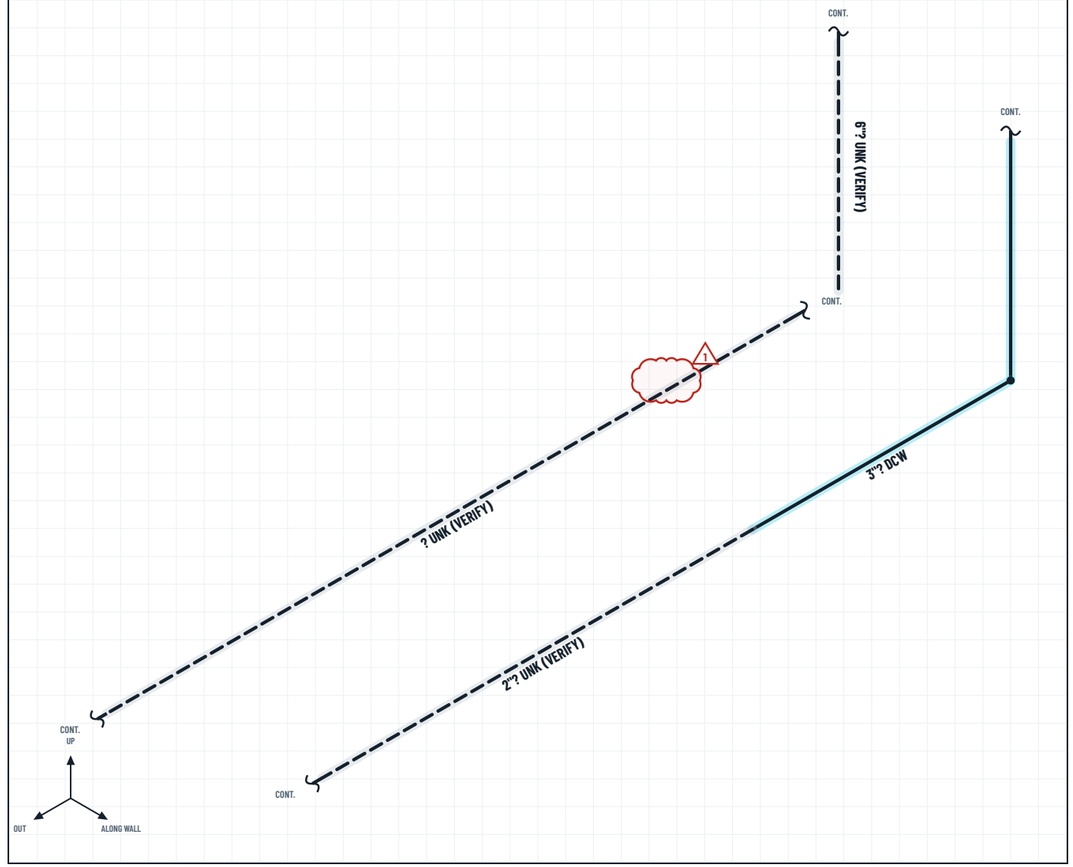

AS-BUILT ISOMETRIC — CEILING SPACE ABOVE CORRIDOR — LOW LIGHT

N.T.S. · DERIVED FROM PHOTO FT-06 · DIMENSIONS ESTIMATED

MARKUP SUMMARY — 14 MARKUPS · 2 ISSUES · 10 BELOW 70%

SUBJECT	LABEL	LAYER	STATUS	CONF.
Polyline	6"? UNK	Pipe Runs	None	66%
Pipe Tag	UNK 6"?	Labels	None	66%
Polyline	3"? DCW	Pipe Runs	None	71%
Pipe Tag	DCW 3"?	Labels	None	71%
Polyline	2"? UNK	Pipe Runs	None	58%
Pipe Tag	UNK 2"?	Labels	None	58%
Polyline	1-1/2"? UNK	Pipe Runs	None	61%
Pipe Tag	UNK 1-1/2"?	Labels	None	61%
Polyline	? UNK	Pipe Runs	None	52%
Pipe Tag	UNK ?	Labels	None	52%
Clevis / band (verify)	Clevis / band (verify)	Hangers & Supports	None	63%
Elbow (copper)	3"? Elbow (copper)	Fittings	None	60%
Cloud+	Low confidence — re-shoot or verify	Issues	None	95%
Cloud+	Occluded by lift & worker	Issues	None	90%

GENERAL NOTES

1. NOT ISSUED — HELD FOR REVIEW
2. DASHED RUNS BELOW 70% CONFIDENCE
3. SIZES UNVERIFIED (NO SCALE REFERENCE)

LEGEND

- UNK — Unidentified — verify
- DCW — Domestic Cold Water
- Below 70% — verify

REVISION CLOUDS

△1 Low confidence — re-shoot or verify (High)

△2 Occluded by lift & worker (Medium)

FIELD TRACE

MIMETIC TECHNOLOGY · MIMETICTECH.AI
80/20 SOFTWARE · PROTOTYPE

PROJECT: Sample Project — Mechanical Rough-In (DEMO-0142)			PREPARED FOR: Schilke Construction	
DRAWING TITLE: AS-BUILT — CEILING SPACE ABOVE CORRIDOR — LOW LIGHT			LOCATION: Level B1 · Corridor D ceiling	
SOURCE PHOTO: FT-06 · 2026-11-11 16:48	DRAWN: FIELD TRACE AI	CHECKED: —	SCALE: N.T.S.	REV: A
STATUS: HELD — NEEDS FIELD VERIFICATION			SHEET: FT-06	